

Note: Improvements on this lot are not in a flood hazard area.


WESTMINISTER STREET
WATER & SEWER IN ST R/W

FILED GREENVILLE CO. S.C.

MAY 3 2 18 PM '82

DONNIE S. TANKERSLEY R.M.C.

PROPERTY OF
A. COLETTA & PHYLLIS S. COLETTA
GREENVILLE COUNTY, SIMPSONVILLE, S.C.
SCALE: 1"=40' 29 APR 1982

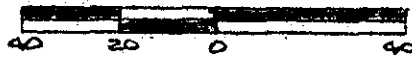

This is to certify that on the 29th day of April, 1982, I surveyed the property shown on this plat, being known as lot 73 on plat of WEMBERLY JAY and recorded in the RMC Office Greenville County, S. C., in Plat Book " 7 - C " at Page 39; and that the property lines, walls and buildings are as shown hereon, and that the walls and buildings located on said lot do not encroach or project on adjacent street or property, and that no adjacent walls or buildings encroach or project on said premises, and no power lines cross this property except as shown hereon.

24464 ✓

9-B-28

R. B. Bruce
R. B. Bruce, RL 71952

CAROLINA SURVEYING CO.

112 Hanly St.
Greenville, S.C. 29603

027

3.00CD