


This is to certify that on June 25, 1982, I surveyed the property shown on this plat, known as Lot 20 on plat of Devenger Place Sec. 7, recorded in the RMC Office of Greenville County in Plat Book 5P on page 3, and that the property lines, walls and buildings are as shown hereon; that the building located on said lot does not encroach or project on adjacent streets or property, and that no adjacent walls or buildings encroach or project on said premises, and that no utility lines cross this property except as shown hereon. This property is not located in a designated flood hazard area.

5' drainage and utility easement along all side and rear lot lines.


**RICHFIELD TERRACE**

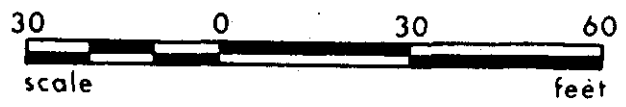

*James R. Freeland*  
James R. Freeland PLS & PE 4781

9-C-27 ✓ 29285

FILED  
JUN 25 3 41 AM '82  
DONNIE CANKERSLEY  
R.M.C.

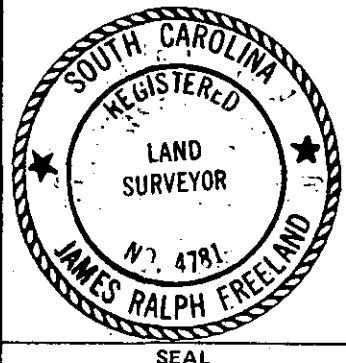

**STATE OF SOUTH CAROLINA  
GREENVILLE COUNTY**

DEVENGER PLACE  
SEC. 7; LOT 20  
PROPERTY OF  
TED A. MANIOS  
MIRIAM P. MANIOS

FREELAND & ASSOCIATES  
Engineers • Land Surveyors

GREENVILLE, S.C.

SURVEY W&M III
DRAWN B.R.
CHECK MLC
SCALE 1" = 30'
DATE JUNE 25, 82
DWG. NO. 7606