


MICROFILMED

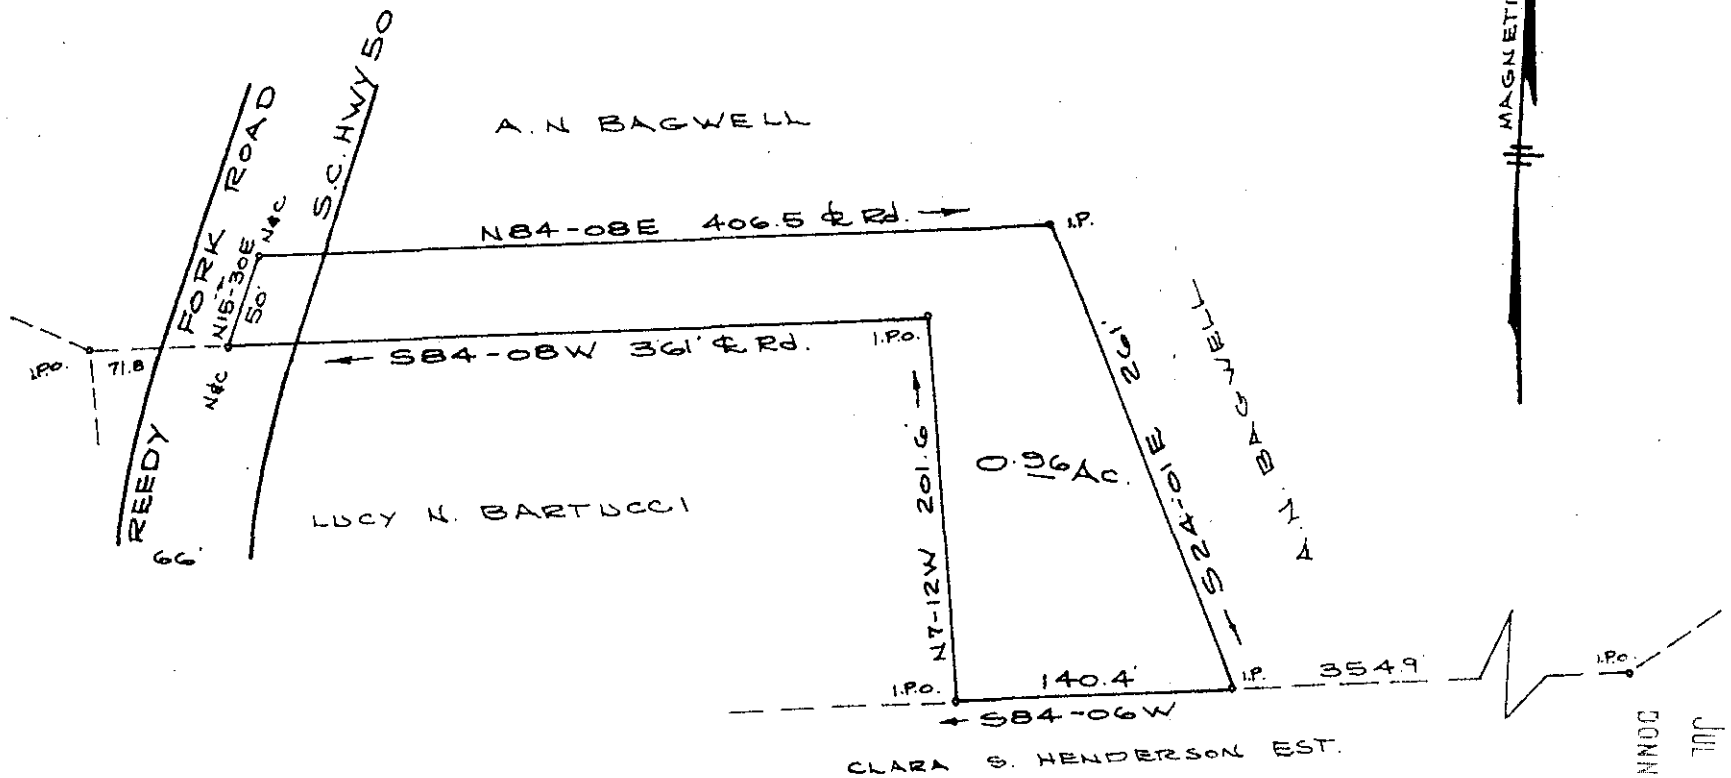


SURVEY FOR
 THOMAS PAUL WILLIFORD

GREENVILLE, CO. SOUTH CAROLINA

SCALE 1"=100'

APRIL 1982

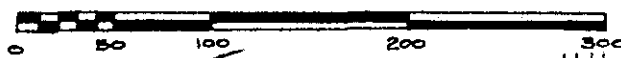

160 ✓

9-2-36

JUL 1 1982

JAMES L. STRICKLAND LAND SURVEYOR
 RT. 3 BOX 288AA
 PELZER, S. C. 29669
 (803) 243-3278

I HEREBY CERTIFY THAT THE
 PRECISION OF THE FIELD SURVEY
 IS 1:5000, AND THE AREA WAS
 DETERMINED BY O.M.D. METHOD
 OF AREA CALCULATION.

SOUTH CAROLINA
 REGISTERED
 NO. 4862
 James L. Strickland

TAX MAP 594.1-1-22

DONNIE J. TANNER SURVEYOR

JUL 1 9 35 AM '82

GREENVILLE CO. S.C.

FILED

3.0000

ECTD --- JUL 182 016