


FILED
 CO. S. C.
 JUL 27 3 30 PM '82
 DONNE J. WEAVER SLEY
 A.M.C.

MICROFILMED

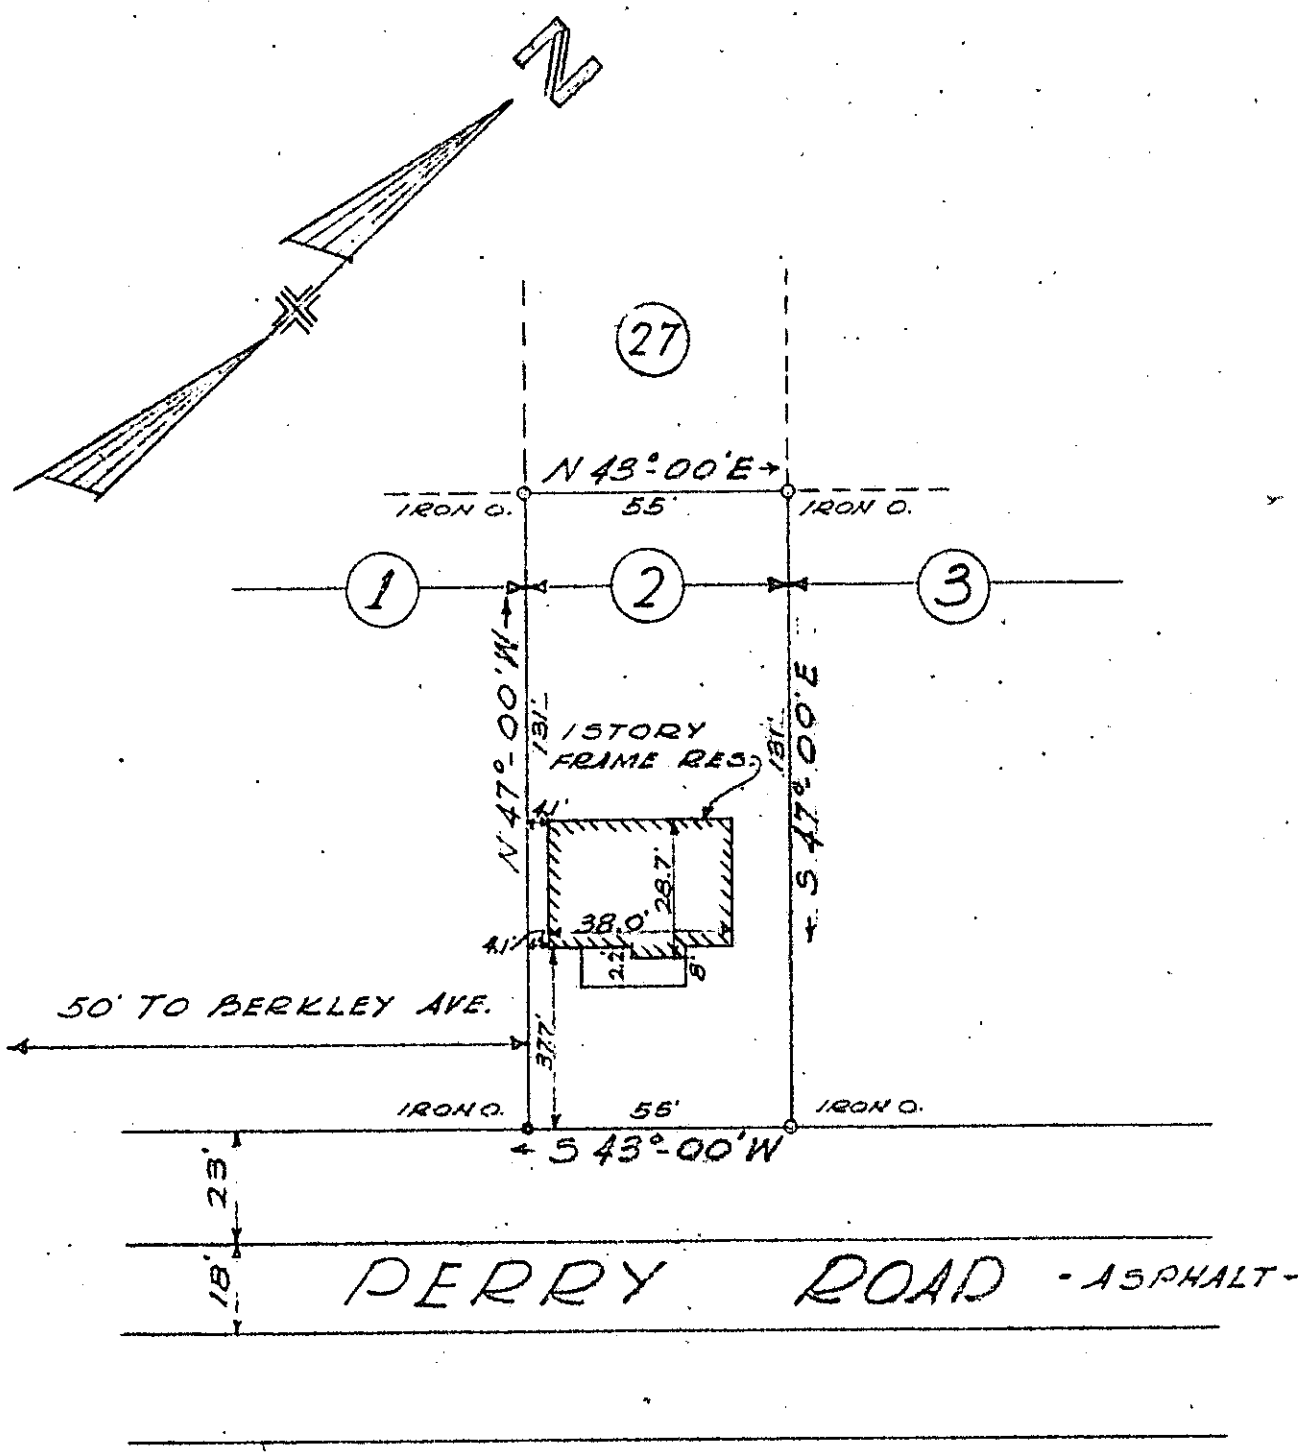

PROPERTY OF: _____
 RUTH J. DEMPSEY & RENEE J. BALLEW

LOCATED NEAR THE
 CITY OF GREENVILLE, S.C.

PICKELL & PICKELL, ENGRS.
 GREENVILLE, S.C.

SCALE: 1" = 40' DATED: JULY 9, 1947

2422

9-6-96

Walter Pickell, REG. ENGR

I HEREBY CERTIFY THAT THE MEASUREMENTS AS SHOWN ON THIS PLAT ARE CORRECT AND THERE ARE NO PROJECTIONS OR ENCROACHMENTS OTHER THAN SHOWN