

N/F RAINEY
DEED 461-280

9.92± ACRES
TOTAL

OLINGER
PLAT 60/33

CARR
PLAT 60/83

BLAKELY

HUNTLEY

OLINGER
PLAT 60/33

1127-53

1558-1 TO JERRY RD.
CARR RD.

REF IP @ 14.0'

445.31 TOT.
5.00-42E
1.0.
762.37 TOT.
346.59
S 18-02E

N 12-14 W
195.15 TOT.

246.85
S 84-27 W
1.0.

MAG N

	BEARING	DISTANCE
3	N 46-47E	122.24
4	N 56-01E	180.03
5	N 4-15 W	40.79
6	N 68-27E	89.01
7	N 29-48 W	53.28
8	N 21-37E	25.75
9	N 52-05E	49.21
10	S 56-13 E	26.02
11	S 3-34 E	27.94 (REF)
12	S 3-34 E	28.36 (REF)
13	N 78-02 E	160.20'
14	N 13-40E	219.34'
15	N 65-59W	34.0'
16	N 65-03W	39.12'
17	N 58-52W	29.10'
18	N 51-40 W	38.23'
19	N 42-13W	34.76'

FILED
GREENVILLE CO. S.C.
SEP 16 2 22 PM '82
DONNIE S. TANKERSLEY
R.M.C.


This is to certify that on Sept-14, 1982, I surveyed the property shown on this plat, known as property of Deborah L. Beddingfield, recorded in the RMC Office of Greenville County in Plat Book 8A on Page 24, and that the property lines, walls, and buildings are as shown hereon; that the building located on said lot does not encroach or project on adjacent streets or property, and that no adjacent walls or buildings encroach or project on said premises and that no utility lines cross this property except as shown hereon. This house is not located in a designated flood hazard area.

James R. Freeland
James R. Freeland RLS & PE 4781


SEP 16 1982
6662

9-D-84

TAX BLOCK BOOK # 594.1-1-36

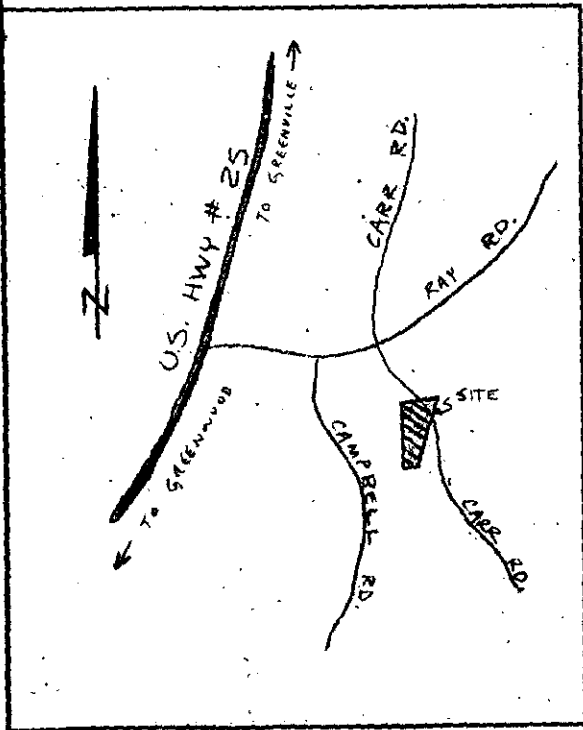

LOCATION MAP

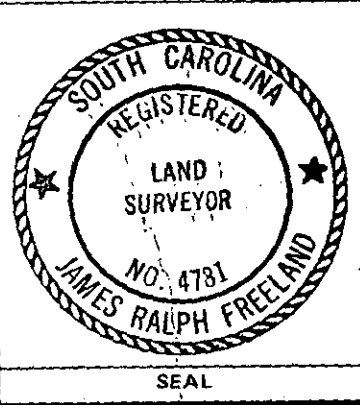

STATE OF SOUTH CAROLINA
GREENVILLE COUNTY

PROPERTY OF
DEBORAH B. WINDHAM

FORMERLY
(DEBORAH L. BEDDINGFIELD)

FREELAND & ASSOCIATES
Engineers • Land Surveyors

GREENVILLE, S.C.

SURVEY LT
DRAWN WBH III
CHECK JRF
SCALE 1" = 200' OACI
DATE 9-14-82
DWG. NO. 80-5134

UNRECORDED