


This is to certify that August 27, 1982, I surveyed the property shown on on this plat, known as Lot 206 on plat of Brentwood, Sec. 4, recorded in the RMC Office of Greenville County in Plat Book 5D on page 43, and that the property lines, walls and buildings are as shown hereon; that the building located on said lot does not encroach or project on adjacent streets or property, and that no adjacent walls or buildings encroach or project on said premises, and that no utility lines cross this property except as shown hereon. This property is not located in a designated flood hazard area.

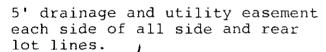

SÉP 1

3192-1-134



STATE OF SOUTH CAROLINA GREENVILLE COUNTY

BRENT WOOD -LOT 206 SIMPSO W.

FREELAND & ASSOCIATES

Engineers • Land Surveyors

GREENVILLE, S.C.

SURVEY JC	
DRAWN MC	
CHECK MC	
SCALE 1"= 40	
DATE 8-27-82	
DWG. NO. 82-78/1	