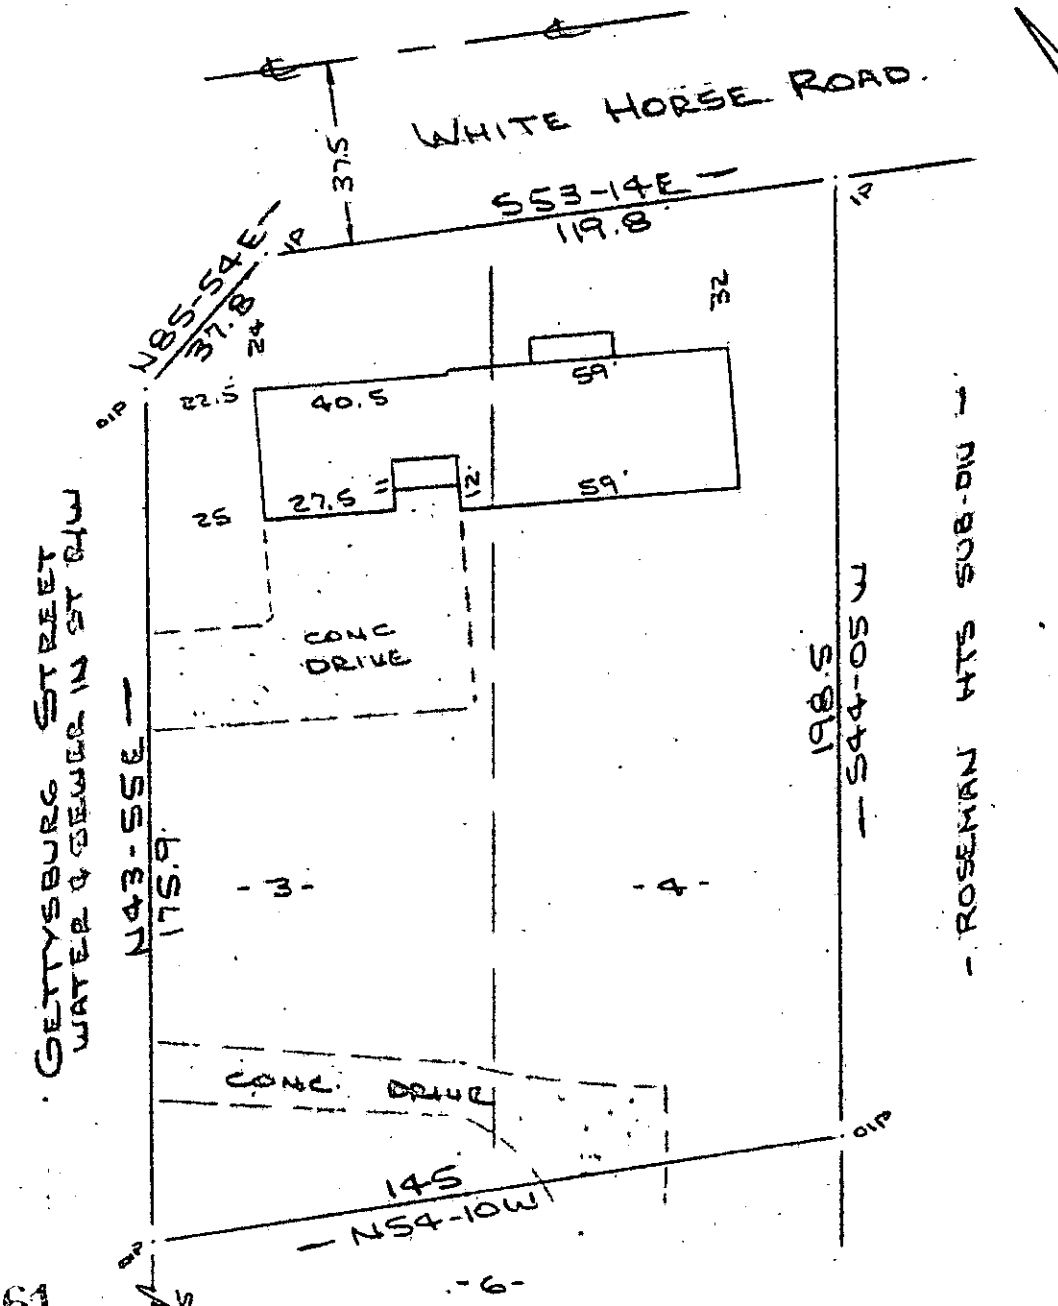

MICROFILMED
MAR 1955

Note: Improvements on this lot are not in a flood hazard area.

FILED
GREENVILLE CO. S. C.
SEP 16 12 20 PM '82
DONNIE S. TANKERSLEY
R.M.C.

6661
SEP 16 1982

9-G-3

PROPERTY OF
RALPH SULLIVAN & ALICE WILLIAMS
NEAR GREENVILLE, S.C.
SCALE: 1"=40 13 SEPT 1982

40' 20 0 40

This is to certify that on the 13th day of September, 1982, I surveyed the property shown on this plat, being known as lots 3 & 4 on plat of LINCOLN COURT and recorded in the RMC Office Greenville County, S. C., in Plat Book " W " at Page 90 and also being known as PROPERTY OF RALPH SULLIVAN & ALICE WILLIAMS and recorded in Plat Book at Page ; and that the property lines, walls and buildings are as shown hereon, and that the walls and buildings located on said lot do not encroach or project on adjacent street or property, and that no adjacent walls or buildings encroach or project on said premises, and no power lines cross this property except as shown hereon.

R. B. Bruce

R. B. Bruce, RLS #1952

CAROLINA SURVEYING CO.
112 Manly St.
Greenville, S. C.

246/12

384-1-40441