


MICROFILMED

FILED
GREENVILLE CO. S.C.
SEP 20 3 35 PM '82
DONNIE S. TANKERSLEY
R.M.C.

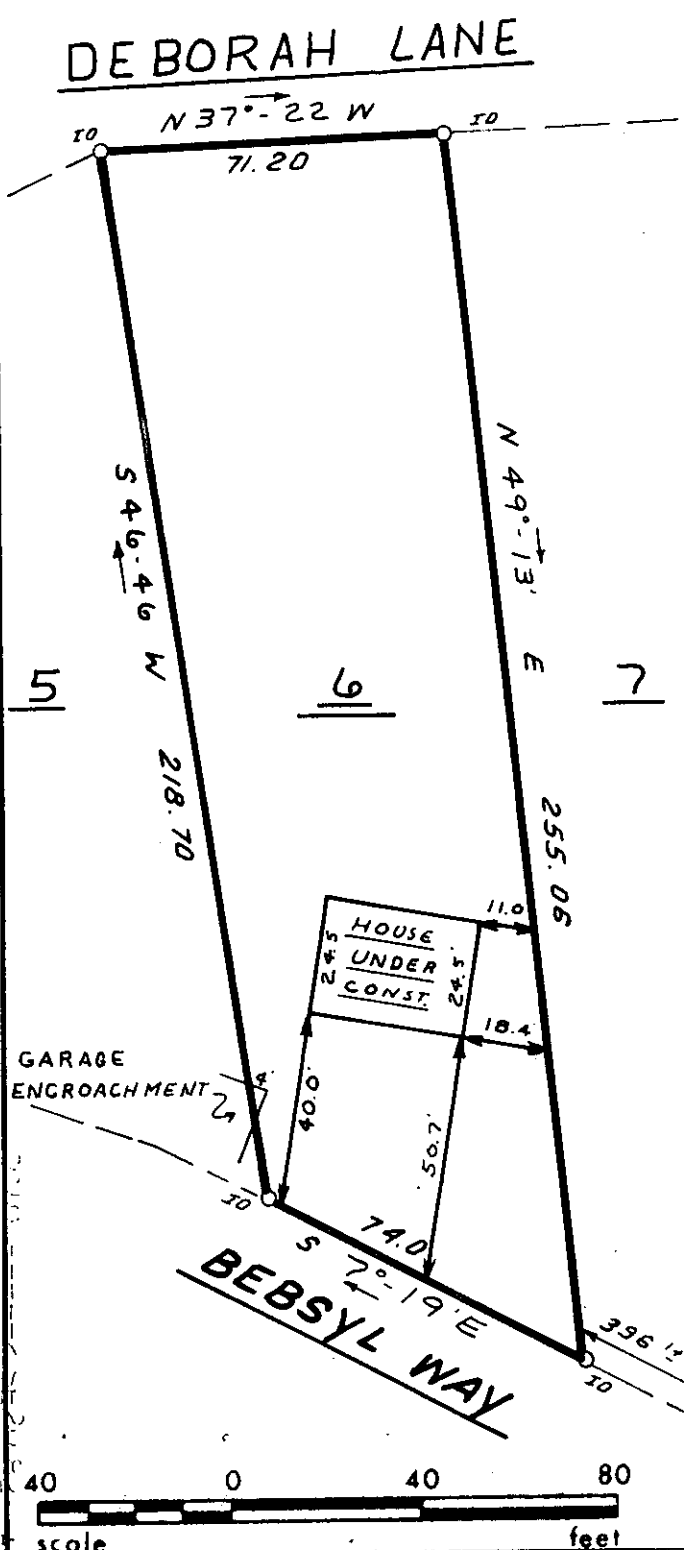

This is to certify that on September 16, 1982, I surveyed the property shown on this plat, known as Lot 6 on Plat of Lakewood, Block A, recorded in the RMC Office of Greenville County in Plat Book Y on page 136 and 137, and that the property lines, walls and buildings are as shown hereon; that the building located on said lot does not encroach or project on adjacent streets or property, and that no adjacent walls or buildings encroach or project on said premises, and that no utility lines, cross this property except as shown hereon. This property is not located in a designated flood hazard area.

James R. Freeland
James R. Freeland PLS & PE 4781

✓ 6952
9-G-12



**STATE OF SOUTH CAROLINA
GREENVILLE COUNTY**

LAKWOOD
BLOCK "A" ; LOT 6
PROPERTY OF
DAVID B. MANN

FREELAND & ASSOCIATES <i>Engineers • Land Surveyors</i>	
GREENVILLE, S.C.	
SURVEY	J.C.
DRAWN	B.R.
CHECK	M.C.
SCALE	1" = 40'
DATE	SEPT. 16, 1982
DWG. NO.	7670