

COPIED  
MICROFILMED

- COZETTE GAULT -

560-28E - 150 TOT

100 50

FILED  
GREENVILLE CO. S.C.

SEP 23 2 56 PM '82

DONNIE S. TANKERSLEY  
R.M.C.

- SARA A. PAYTON,  
ET AL -

Note: Improvements on  
this lot are not in a  
flood hazard area.

N27-20E  
242.4

269.7  
S27-30W

7251

151.7 TOT - N52-00W

2213.4


JONES MILL ROAD

BELMONT DRIVE  
WATER & SEWER IN ST R/W

9.6-20

SEP 23 1982


PROPERTY OF  
RONALD E. FOULIOT & MARION P. FOULIOT  
GREENVILLE COUNTY, FOUNTAIN INN, S.C.  
SCALE: 1" = 50' 17 SEPT. 1982

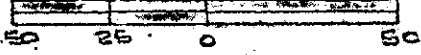

This is to certify that on the 17th day of September, 1982, I surveyed the property shown on this plat, being known as lot 26 and part of lot 25 on plat of BELMONT ESTATES and recorded in the RMC Office Greenville County, S. C., in Plat Book "PPP" at Page 87; and that the property lines, walls and buildings are as shown hereon, and that the walls and buildings located on said lot do not encroach or project on adjacent street or property, and that no adjacent walls or buildings encroach or project on said premises, and no power lines cross this property except as shown hereon.

*R. B. Bruce*

R. B. Bruce, R/S #1952

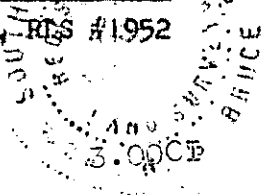

CAROLINA SURVEYING CO.

112 Main St  
Greenville, S.C. 29602

168