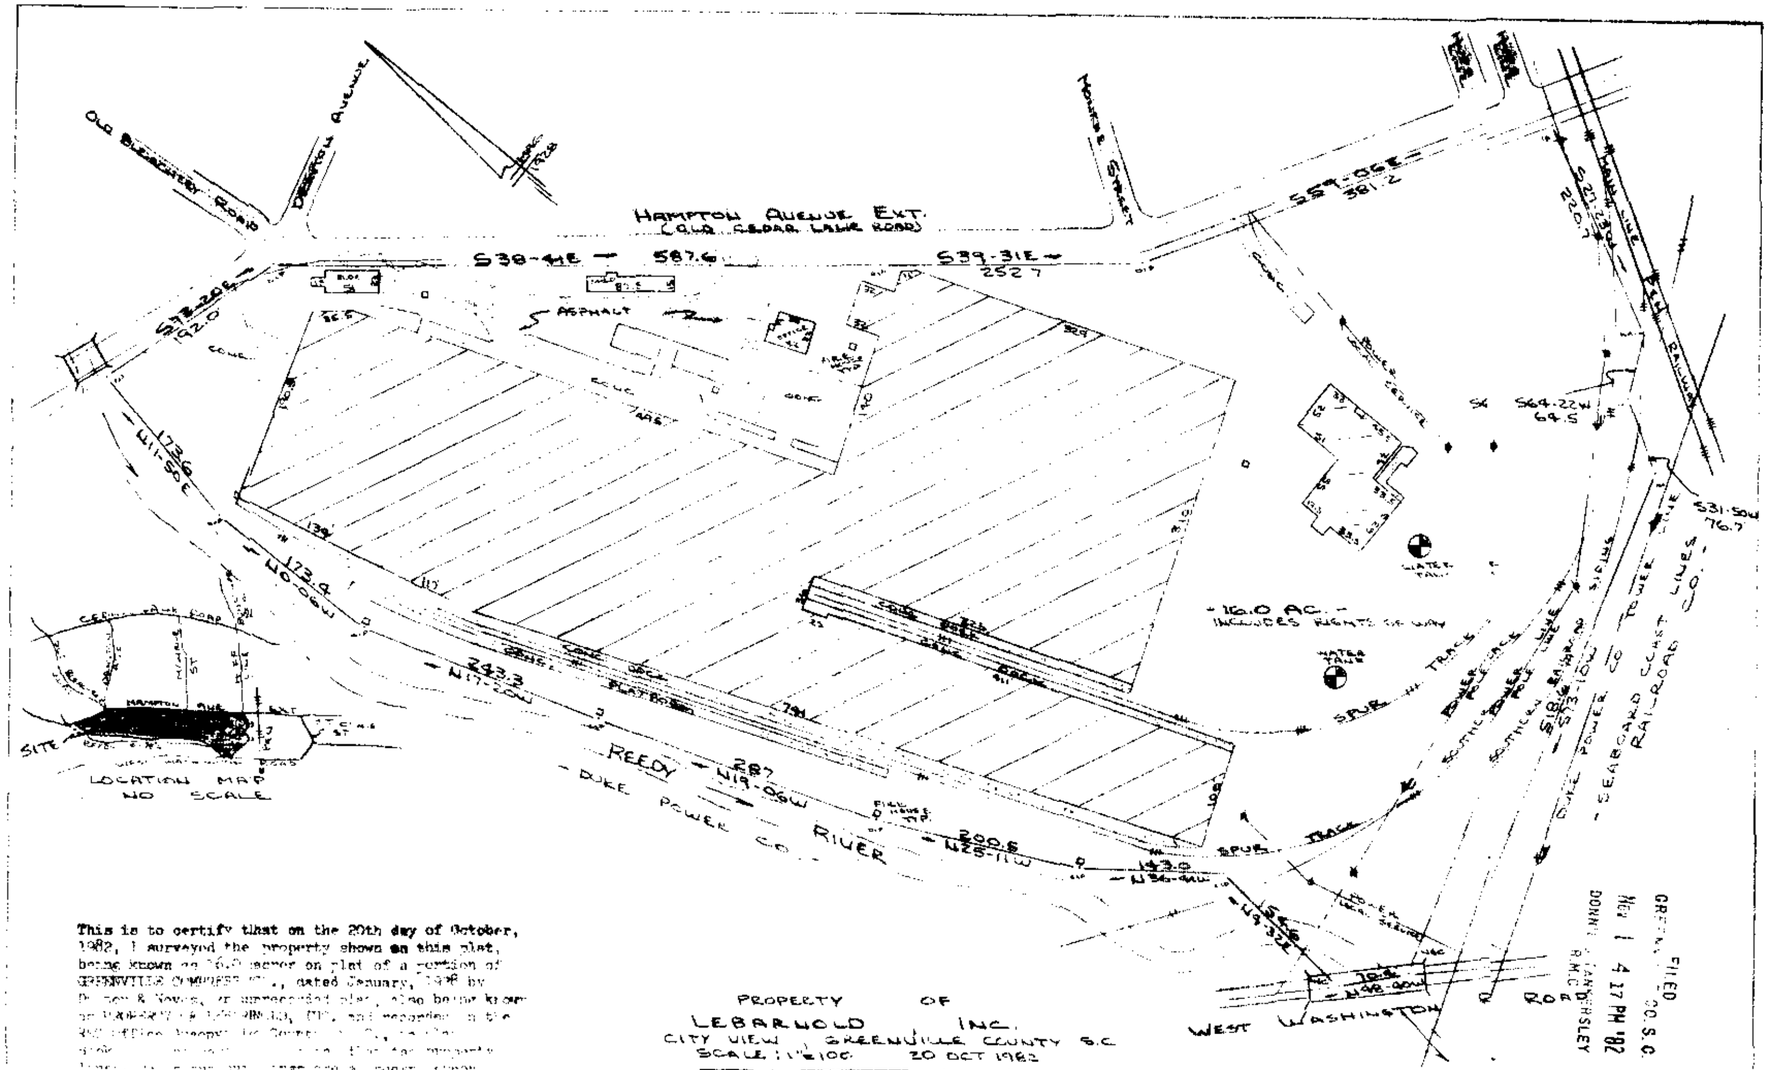

This is to certify that on the 20th day of October, 1982, I surveyed the property shown on this plat, being known as 16.0 acres on plat of a portion of GREENVILLE COMMERCE CT., dated January, 1978 by Dixon & Young, an unrecorded plat, also being known as PROPERTY OF LEBARNOLD, INC., and recorded in the Register Office for Greenville County, S.C. in the grant [illegible] property [illegible] and other rights of way and easements, if any, as may be [illegible] on the ground or as shown on the plat [illegible] and that the [illegible] is correct to the best of my knowledge, information and belief.

R. B. Brulle

I Certify That The Ratio Of Precision Of An Of The Field Survey Is 1/7500 As Shown Hereon And Is And That The Area Determined By D.M.D. Method Of Area Of Area Calculations.

CAROLINA SURVEYING CO.
112 MANLY ST.
GREENVILLE, S.C.

SCTC --- 1 NOV 1 82 1241 1243 5.00CI

2.95/36

MC-1-1