



Note:  
Improvements on this  
lot are not in a flood  
hazard area.

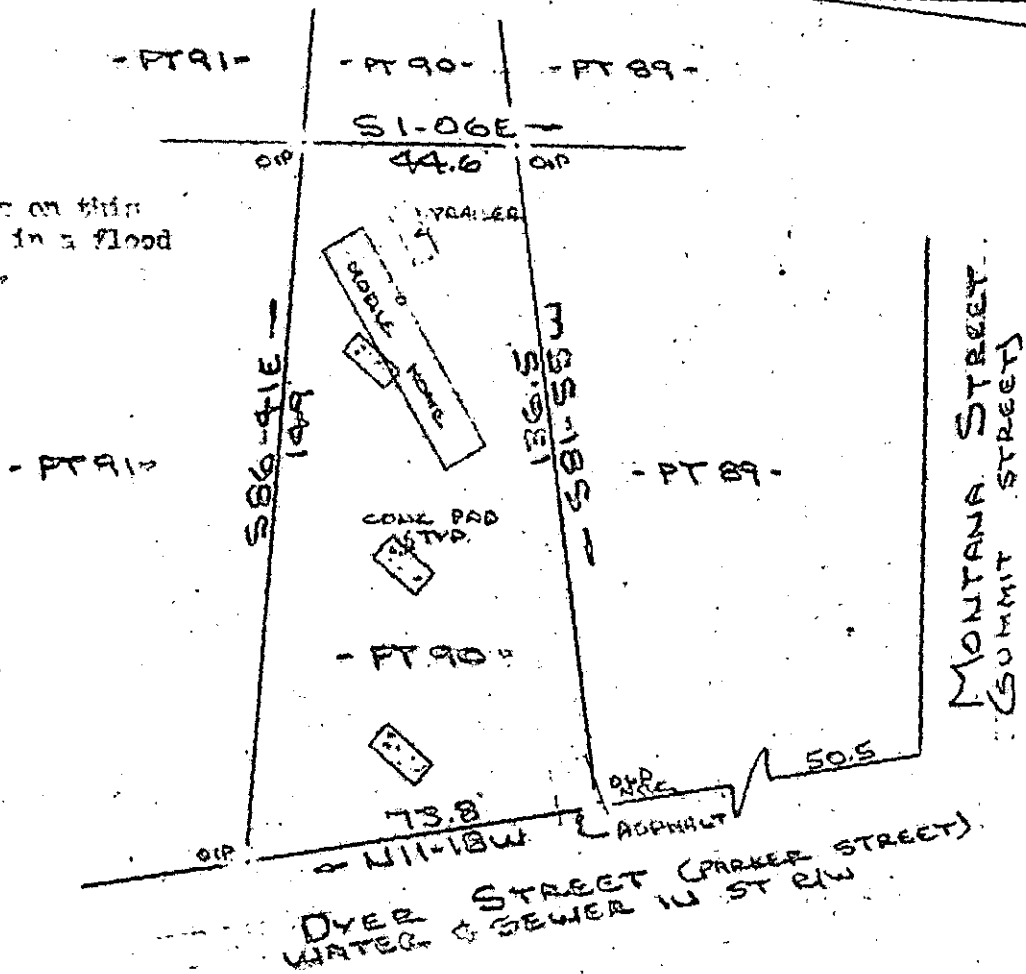

FILED  
 CO. S. C.  
 Nov 18 12 57 PM '82  
 BONNIE S. TANKERSLEY  
 R.M.C.

PROPERTY OF  
**BONNIE J. KELLER**  
 CITY VIEW, GREENVILLE COUNTY, S.C.  
 SCALE: 1"=40' 17 NOV 1982

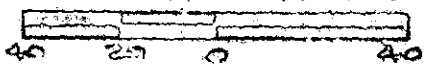

This is to certify that on the 17th day of November, 1982, I surveyed the property shown on this plat, being known as part of lot 90 on plat of FORD HILL and recorded in the Hill Office Greenville County, S. C., in Flat Book "A" at Page 90 and also being known as PROPERTY OF BONNIE J. KELLER and recorded in Flat Book at Page 90; and that the property lines, walls and buildings are as shown hereon, and that the walls and buildings located on said lot do not encroach or project on adjacent street or property, and that no adjacent walls or buildings encroach or project on said premises, and no narrow lanes cross this property except as shown hereon.

OCTO ----- 3 NO 18 82 022 3.00CD

9-I-41 ✓ 12174

