


FILED
 GREENVILLE CO. S. C.
 NOV 30 12 55 PM '82
 BONNIE S. TANKERSLEY
 R.M.C.

This is to certify that on November 26, 1982, I surveyed the property shown on this plat, known as Part Lot 3, on Plat of Walter P. Prince Et. Al. property, recorded in the RMC Office of Greenville County in Plat Book U on page 69B, and that the property lines, walls, and buildings are as shown hereon; that the building located on said lot does not encroach or project on adjacent streets or property, and that no adjacent walls or buildings encroach or project on said premises, and that no utility lines cross this property except as shown hereon. This property is not located in a designated flood hazard area.

James R. Freeland
 James R. Freeland PLS & PE 4781

9I-58

13133

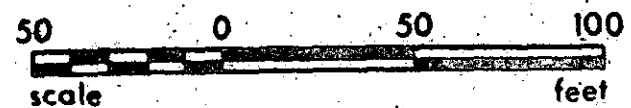

REF.: 451-1-19.1

300'
8
1081888
1081888

	<p>STATE OF SOUTH CAROLINA GREENVILLE COUNTY</p>	<p>FREELAND & ASSOCIATES Engineers • Land Surveyors</p> <p>GREENVILLE, S.C.</p>
	<p><u>WALTER P. PRINCE ET AL.</u> <u>PT. LOT 3</u> <u>PROPERTY OF</u> <u>DON B. BURNS</u></p>	<p>SURVEY <u>L.T.</u> DRAWN <u>B.R.</u> CHECK <u>M.L.C.</u> SCALE <u>1" = 50'</u> DATE <u>NOV. 26. 82</u> DWG. NO. <u>8124</u></p>