MICROFILMED

REF. - TAX MAP No. 686.4-1-5

FILED
GREENVILLE CO. S.C.
FEB 28 4 48 PM '83
DONNIE S. TANKERSLEY
R.M.C.

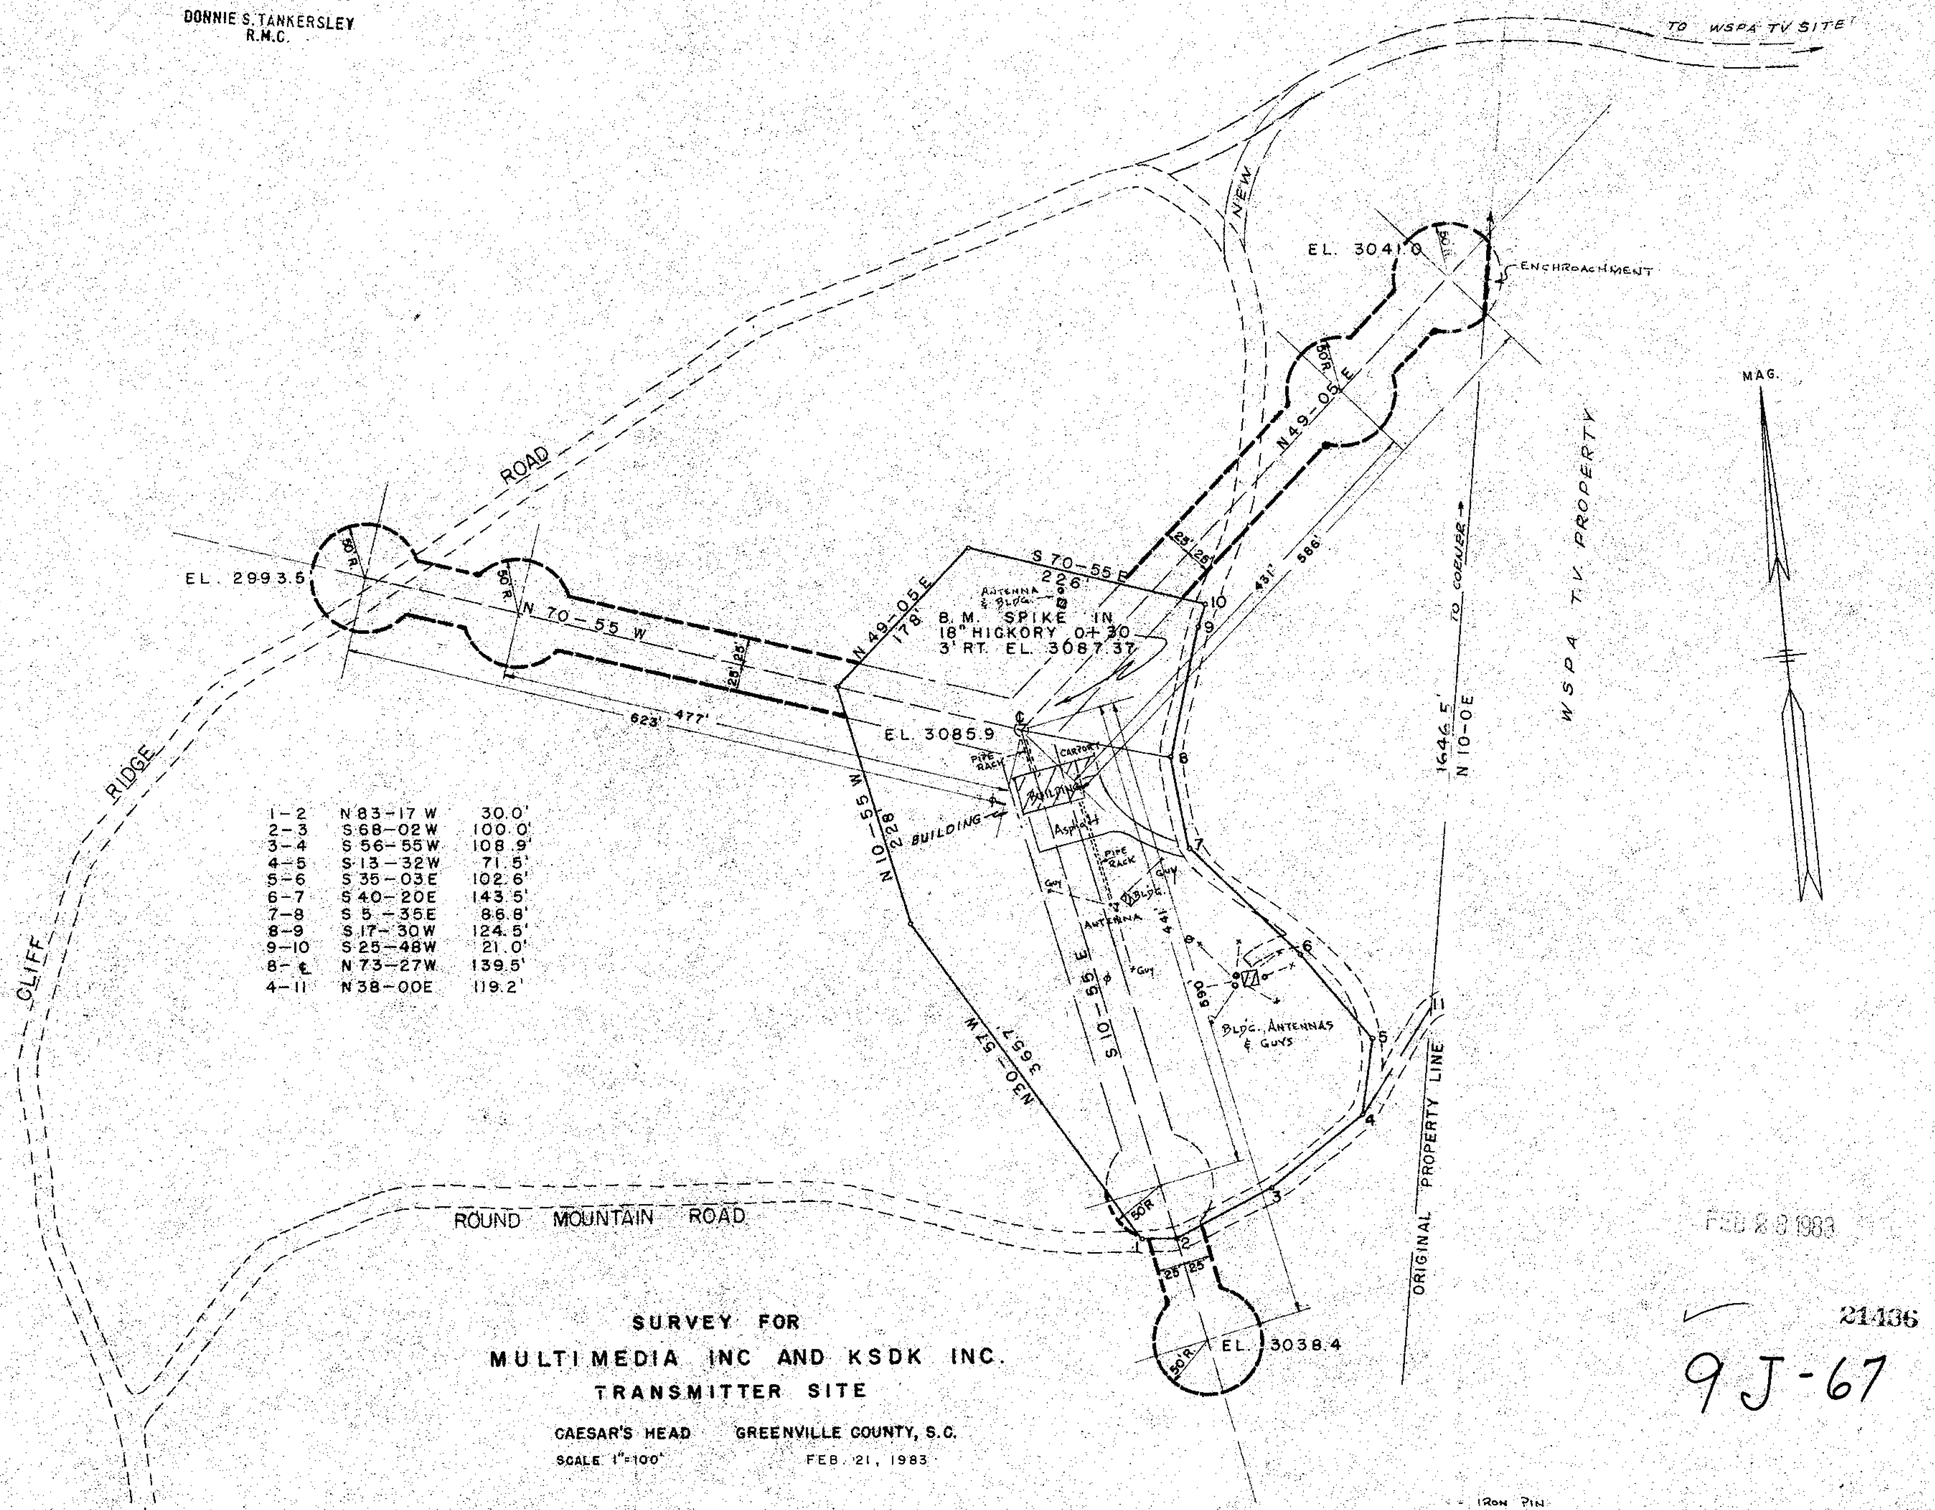

1-2	N 83-17 W	30.0'
2-3	S 68-02 W	100.0'
3-4	S 56-55 W	108.9'
4-5	S 13-32 W	71.5'
5-6	S 35-03 E	102.6'
6-7	S 40-20 E	143.5'
7-8	S 5-35 E	86.8'
8-9	S 17-30 W	124.5'
9-10	S 25-48 W	21.0'
8-℄	N 73-27 W	139.5'
4-11	N 38-00 E	119.2'

SURVEY FOR
MULTIMEDIA INC AND KSDK INC.
TRANSMITTER SITE

CAESAR'S HEAD GREENVILLE COUNTY, S.C.
SCALE 1"=100' FEB. 21, 1983

NOTE
ORIGINAL SURVEY FOR
W.M.R.C. INCORPORATED
MAY 21, 1958 REV. MAY 19, 1958

PIEDMONT SURVEYORS
GREENVILLE, SOUTH CAROLINA

I HEREBY CERTIFY THAT THE MEASUREMENTS AS SHOWN ARE CORRECT AND THERE ARE NO ENCHROACHMENTS OR PROJECTIONS OTHER THAN SHOWN.
James D. Lean
RLS No. 3720

FEB 28 1983

21436

9J-67

CGTO 3 FE28 83 003 5.0000