

This is to certify that on December 9, 1982, I surveyed the property shown on this plat, known as Lot 18 and Part Lot 19 on Plat of James Arrowood Property, recorded in the RMC Office of Greenville County in Plat Book RRR on Page 45, and that the property lines, walls and buildings are as shown hereon; that the building located on said lot does not encroach or project on adjacent streets or property, and that no adjacent walls or buildings encroach or project on said premises, and that no utility lines cross this property except as shown hereon. This property is not located in a designated flood hazard area.

*James R. Freeland*  
 James R. Freeland PLS & PE 4781



INDEX: William E. Galloway and  
 Heidi K. Galloway  
 Route 8, 17 Rison Rd.  
 Greenville, SC 29611

9-K-1

14432

DEC 14 1982

FILED  
 DEC 14 11:25 AM '82  
 DONNIE J. TANKERSLEY  
 R.M.C.

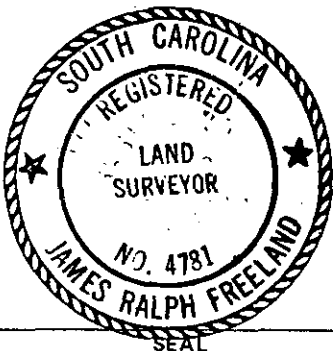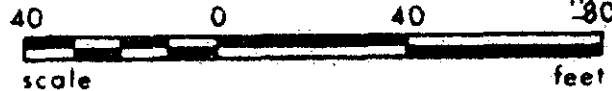

STATE OF SOUTH CAROLINA  
 GREENVILLE COUNTY

JAMES ARROWOOD PROP.  
LOT 18 & PT. LOT 19  
PROPERTY OF  
WILLIAM E. GALLOWAY  
HEIDI K. GALLOWAY

FREELAND & ASSOCIATES  
 Engineers • Land Surveyors

GREENVILLE, S.C.

SURVEY L.T.  
 DRAWN B.R.  
 CHECK MC  
 SCALE 1" = 40'  
 DATE DEC. 9. 82  
 DWG. NO. 8157