


JAN 5 1983


16379  
9-K-96

TO S-23-543 0.4 MI. ± S-23-154

This is to certify that on DEC. 24, 1982, I surveyed the property shown on this plat, recorded in the C.O.C. Office of GREENVILLE County in Plat Book \_\_\_ on page \_\_\_, (D.B. 1151 at Page 924) and that the property lines, walls and buildings are as shown hereon; that the buildings located on said lot do not encroach or project on adjacent streets or property, and that no adjacent walls or buildings encroach or project on said premises, and that no utility lines cross this property except as shown hereon. This property is not located in a designated flood hazard area.

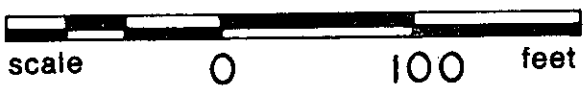

*F. V. Clinkscales Jr.*  
F. V. Clinkscales Jr. PLS & PE 5767

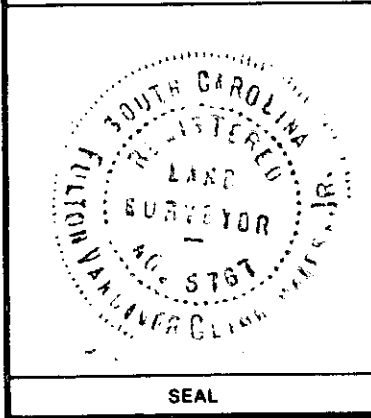

STATE OF SOUTH CAROLINA  
GREENVILLE COUNTY  
PROPERTY OF  
KENNETH RAY CLARK

FREELAND & ASSOCIATES Engineers Land Surveyors 129 E. MAIN ST. CLINTON, S.C. phone: 984-2316	
SURVEY	FVC
DRAWN	ZVC
CHECK	
SCALE	1" = 100'
DATE	12/26/82
DWG. NO.	L 2303 GV