

This is to certify that on December 22, 1982, I surveyed the property shown on this plat, known as Lot 224 on Plat of Peppertree, Sec. 2, recorded in the RMC Office of Greenville County in Plat Book 4X on Page 3, and that the property lines, walls and buildings are as shown hereon; that the building located on said lot does not encroach or project on adjacent streets or property, and that no adjacent walls or buildings encroach or project on said premises, and that no utility lines cross this property except as shown hereon. This property is not located in a designated flood hazard area.

*James R. Freeland*  
James R. Freeland PLS & PE 4781


GREENVILLE CO. S.C.  
JAN 5 3 35 PM '83  
BONNIE STARNES SLEY  
R.M.C.

5' drainage & utility easement each side of all side and rear lot lines.

9-K-98

16448

JAN 5 10 02

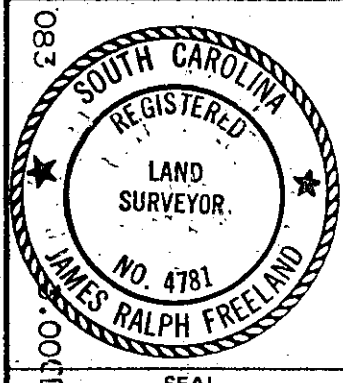

**STATE OF SOUTH CAROLINA  
GREENVILLE COUNTY**

PEPPERTREE  
SEC. 2, LOT 224  
PROPERTY OF  
HOWARD W. SWOFFORD  
FAYE P. SWOFFORD

FREELAND & ASSOCIATES  
Engineers & Land Surveyors

GREENVILLE, S.C.

SURVEY	J.C.
DRAWN	B.R.
CHECK	M.C.
SCALE	1" = 30'
DATE	DEC. 22. 83
DWG. NO.	8197