
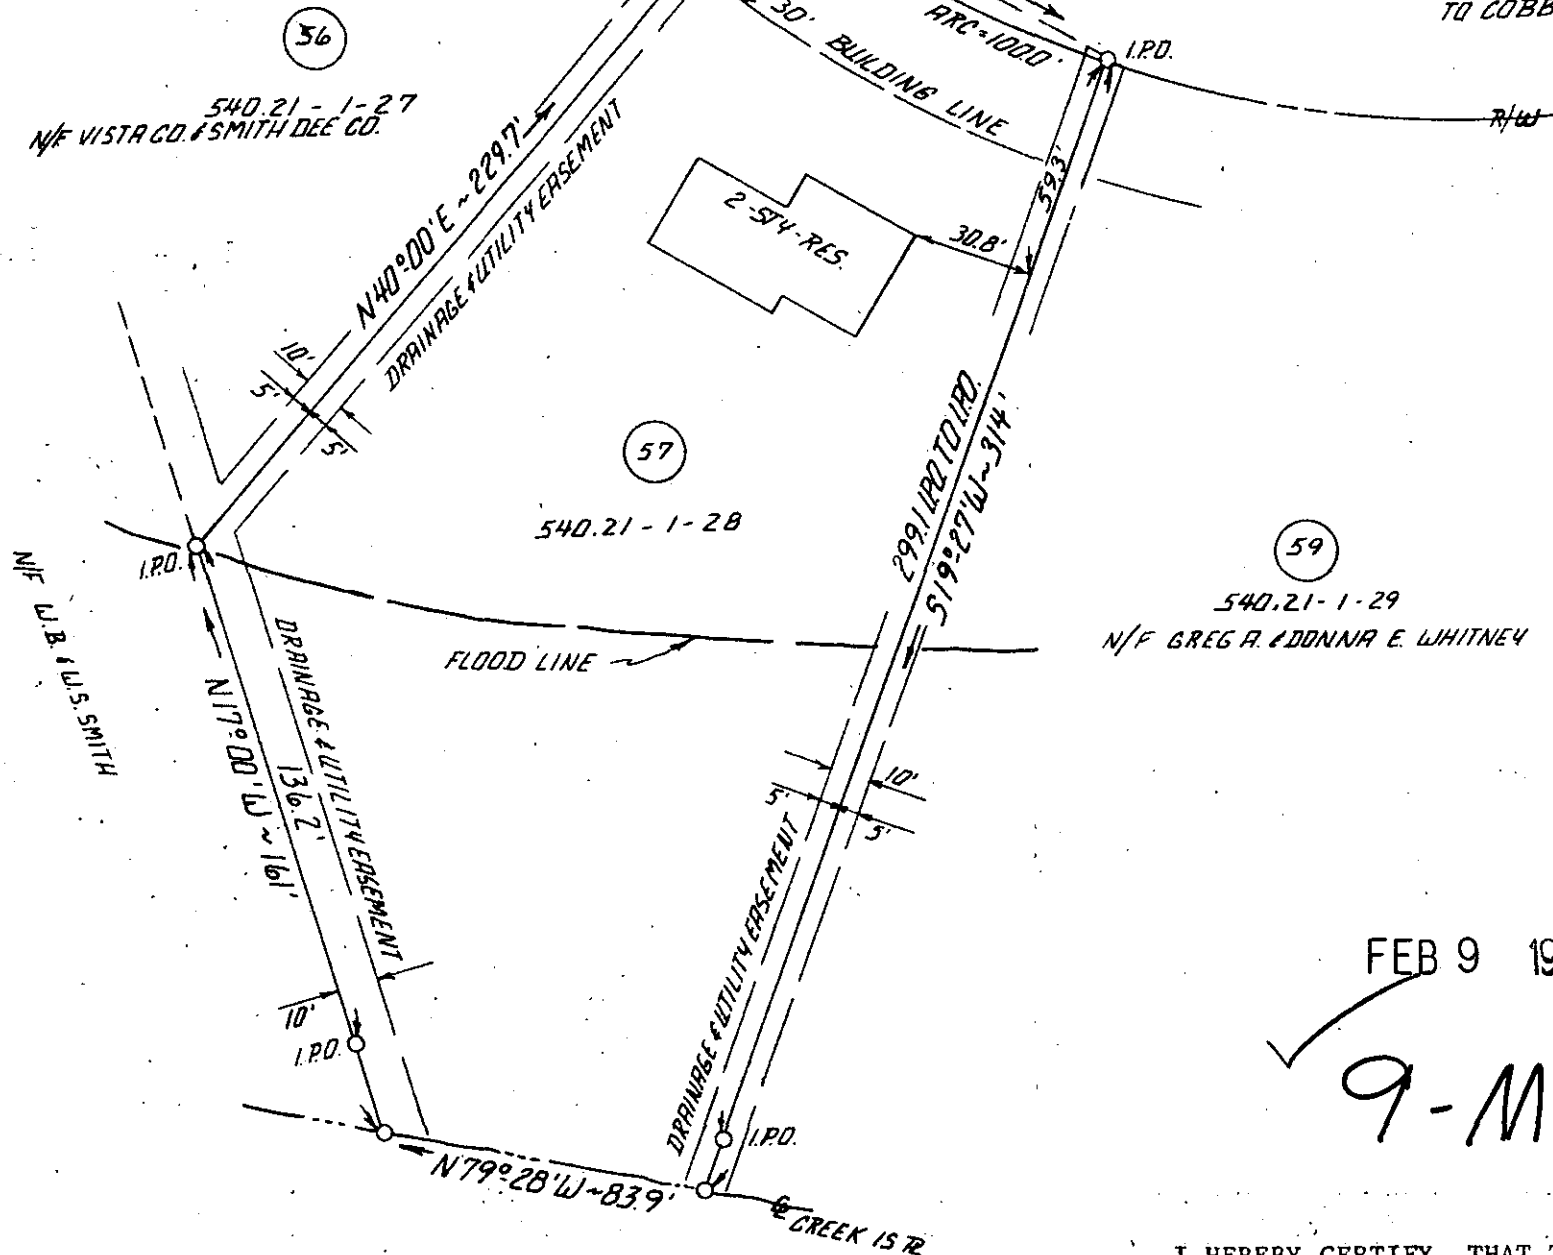


LOCATION MAP N.T.S.

FILED
GREENVILLE CO. S.C.
FEB 9 1 50 PM '83
BONNIE S. TANKERSLEY
R.M.C.

- NOTES:
1. PLAT REFERENCE 7X-88 AT GREENVILLE CO. R.M.C. OFFICE.
 2. REFERENCE BEARING ON LINE BETWEEN LOT 56 & 57
 3. FLOOD LINE TAKEN OFF REFERENCE PLAT
 4. HOUSE UNDER CONSTRUCTION AT THIS TIME - PROPOSED EXTERIOR SIDING & BRICK.
 5. SEWER SERVICE TO CONNECT TO SEWER LINE IN GILDERBROOK RD

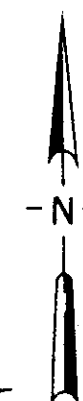

FEB 9 1983
19729

9-M-7

N.F. J.B. & FANNIE FORRESTER JR.



I HEREBY CERTIFY, THAT TO THE BEST OF MY PROFESSIONAL KNOWLEDGE, THE MEASUREMENTS AS SHOWN ABOVE ARE CORRECT AND THERE ARE NO ENCROACHMENTS OR PROJECTIONS OTHER THAN SHOWN.

Thulm Arnold 4032
SURVEYOR'S SIGNATURE S.C. REG. NO.

MICROFILMED

| REV | DATE | BY | DESCRIPTION | APP |
|-----|--------|-----|-------------|-----|
| 1 | 1/9/83 | PLS | ISSUE | |

SURVEY FOR
DOUGLAS CO.
LOT 57 SECTION II
BROOKFIELD WEST.00CI
GREENVILLE CO. SOUTH CAROLINA

enwright associates, inc.
engineers planners surveyors
GREENVILLE, SOUTH CAROLINA

| | | | | |
|---------|---------|---------------|------|--------|
| RS | TMA | TMA | FILE | RETIRE |
| 1/19/83 | 1/15/83 | 83305-50-1-00 | | |
| DATE | SCALE | ISS. NO. | | |