


MICROFILMED

Mc DANIEL AVENUE
WATER & SEWER IN ST RJW

MAG
1976

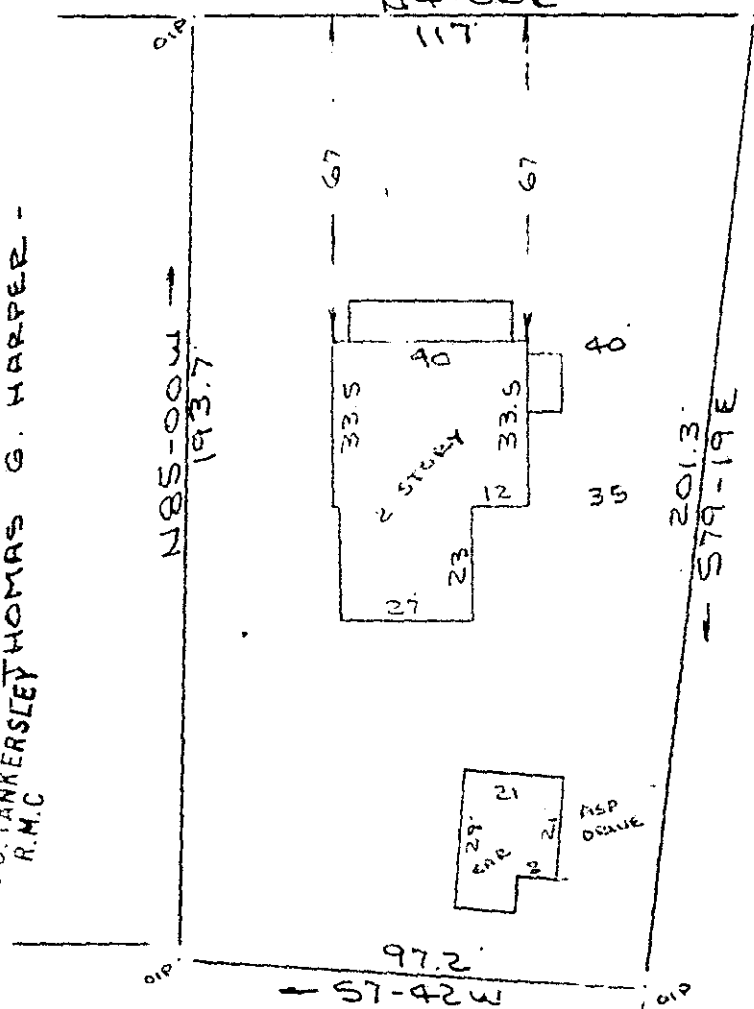


DONNIE S. TANKERSLEY
R.M.C. THOMAS G. HARPER -

CLEVELAND STREET
WATER & SEWER IN ST RJW

FILED
GREENVILLE CO. S.C.
FEB 14 4 30 PM '83

- POLLY A. HUDSON -

PROPERTY OF
T. KEITH HUGGINS
GREENVILLE COUNTY, GREENVILLE, S.C.
SCALE: 1"=40' 10 FEB 1983

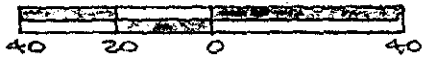

I do hereby certify that on the 10th day of February, 1983, I surveyed the property shown on this plat, being known as the property of T. KEITH HUGGINS and recorded in the REC Office Greenville County, S. C., in Plat Book " " at Page " " and that the property lines, walls and buildings are as shown hereon, and that the walls and buildings located on said lot do not encroach or project on adjacent street or property, and that no adjacent walls or buildings encroach or project on said premises, and no power lines cross this property except as shown hereon.

FEB 14 1983
9-N-19 ✓ 20133

SOUTH CAROLINA
REGISTERED
NO. 1852

R. B. Bruce

CAROLINA SURVEYING CO.
112 Manly St., Greenville, S. C.

R. B. Bruce, R.L.S. 1983

GO TO --- 1 FEL14 837

3.0001