MICROFILMED

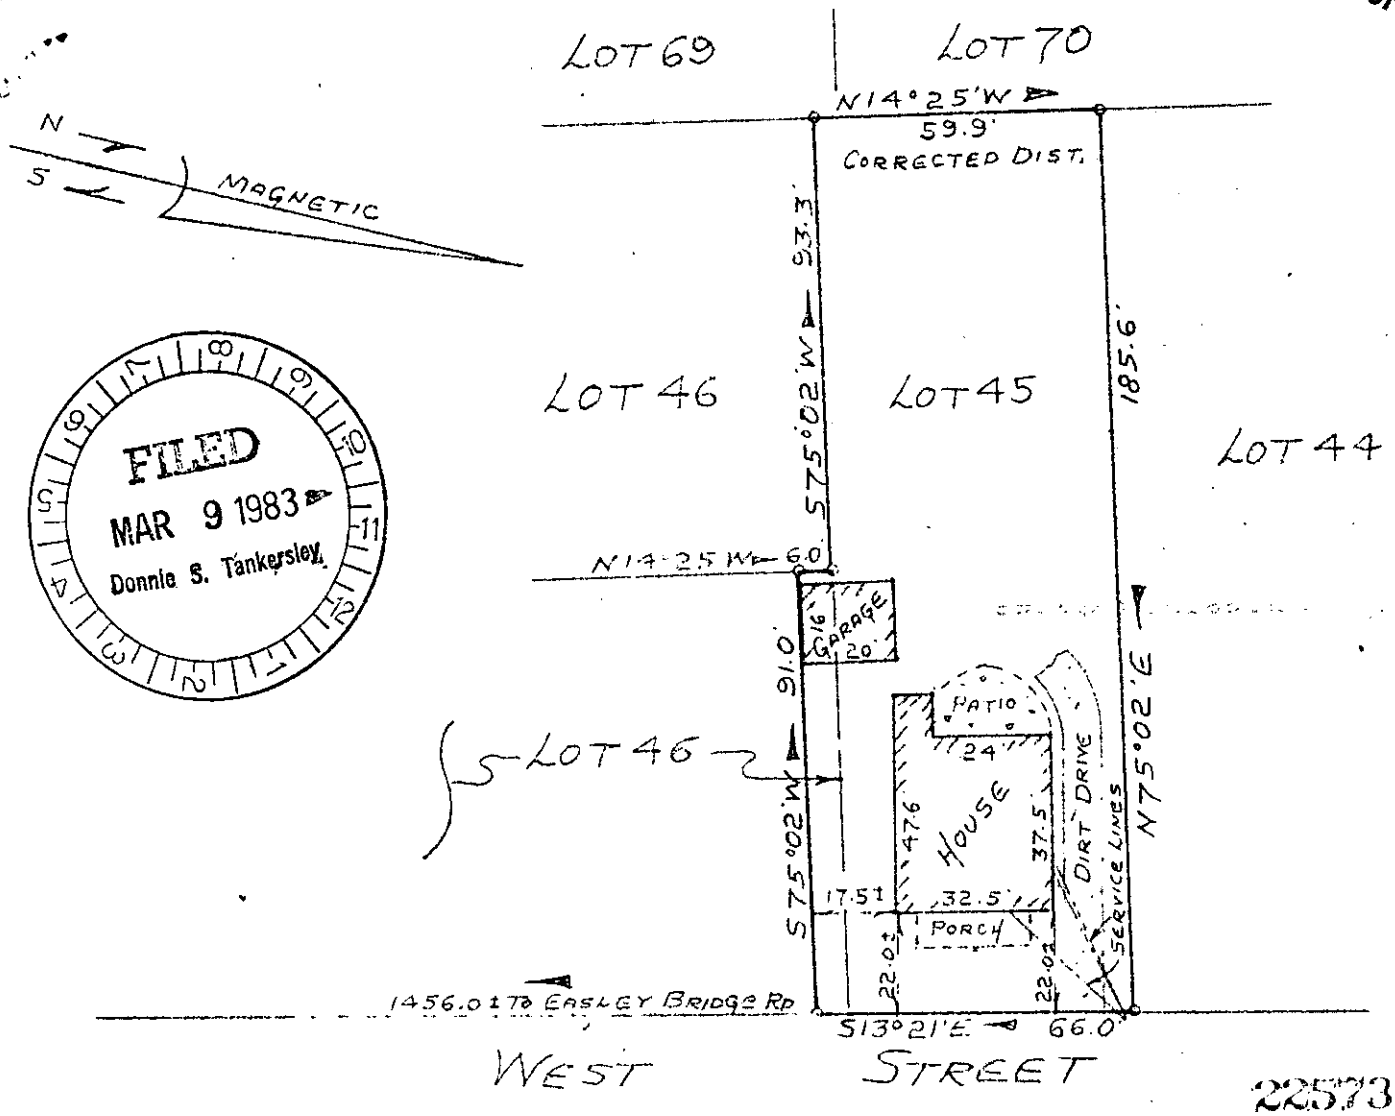

FILED
MAR 9 1983
Donnie S. Tankersley

22573

PROPERTY OF JESSIE L. GRUMBLES

9-0-7

NEAR GREENVILLE, GREENVILLE CO., SO. CAROLINA

MAR 2, 1983 SCALE 1" 40'

MAR 9 1983

This is to certify that on March 2, 1983, I surveyed the property shown on this plat, known as Lot No. 45 and part of Lot No. 46 of Property of J. H. West, as shown on a plat recorded in the RMC Office for Greenville County, in Plat Book C, Page 190, and that the property lines, walls and buildings are as shown hereon, and that the building located on said lot does not project nor encroach on adjacent streets or property, and that no adjacent walls or buildings project nor encroach on said lot, and that no utility lines cross this lot except as may be shown hereon.

NOTE: This property is not located within a flood hazard area.

Survey by: Richard D. Cooten, Jr.
Greenville, South Carolina

S. C. R. L. S. No. 4678

GCTO ----- 3 MAR 1983
3.00CD