FILED
GREENVILLE CO. S. C.
MAR 14 11 23 AM '83
DONNIE S. TANKERSLEY
R.M.C.

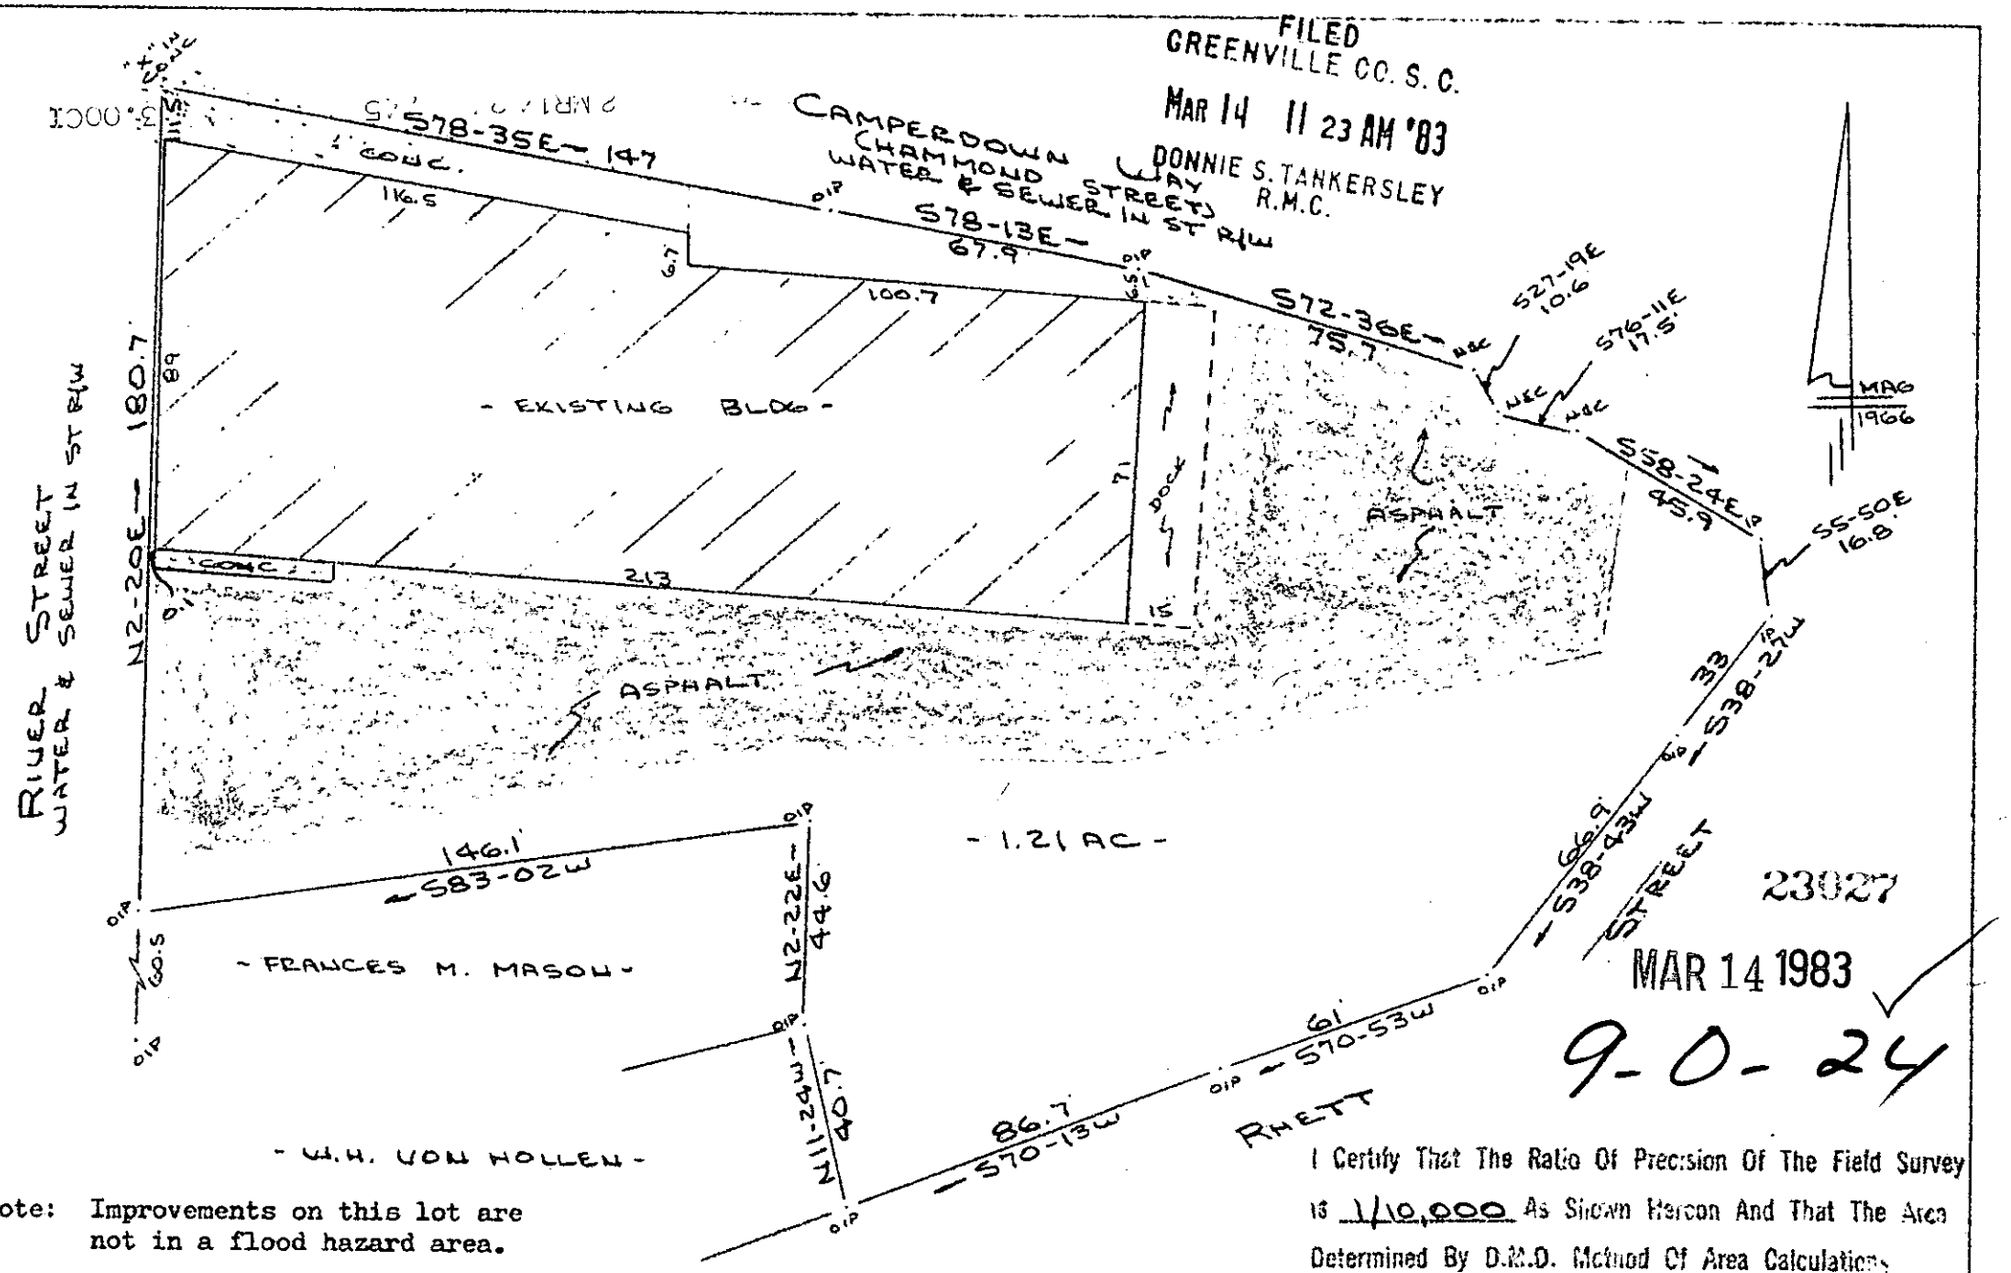

23027

MAR 14 1983

9-0-24

Note: Improvements on this lot are not in a flood hazard area.

I Certify That The Ratio Of Precision Of The Field Survey Is 1/10,000 As Shown Hereon And That The Area Determined By D.M.D. Method Of Area Calculations

PROPERTY OF
SOUTHEASTERN ELECTRICAL DISTRIBUTORS REAL ESTATE COMPANY
GREENVILLE COUNTY, GREENVILLE, S.C.
SCALE: 1"=40' 3 MAR 1983

This is to certify that on the 3rd day of March, 1983, I surveyed the property shown on this plat, being known as 1.21 acres on plat PROP. OF SOUTHEASTERN ELECTRICAL DISTRIBUTORS REAL ESTATE COMPANY and recorded in the RMC Office Greenville County, S. C., in Plat Book at Page ; and that the property lines, walls and buildings are as shown hereon, and that the walls and buildings located on said property do not encroach or project on adjacent street or property, and that no adjacent walls or buildings encroach or project on said premises, and no power lines cross this property except as shown hereon.

R. B. Bruce

CAROLINA SURVEYING CO., 112 Manly St., Greenville, S. C. R. B. Bruce, RLS #1952

MICROFILMED

247/39

71-2-10, 11-13