


"THIS PROPERTY IS NOT LOCATED IN A FLOOD PLAIN."

"THIS PLAT TO BE RECORDED IN THE R.M.C. OFFICE."

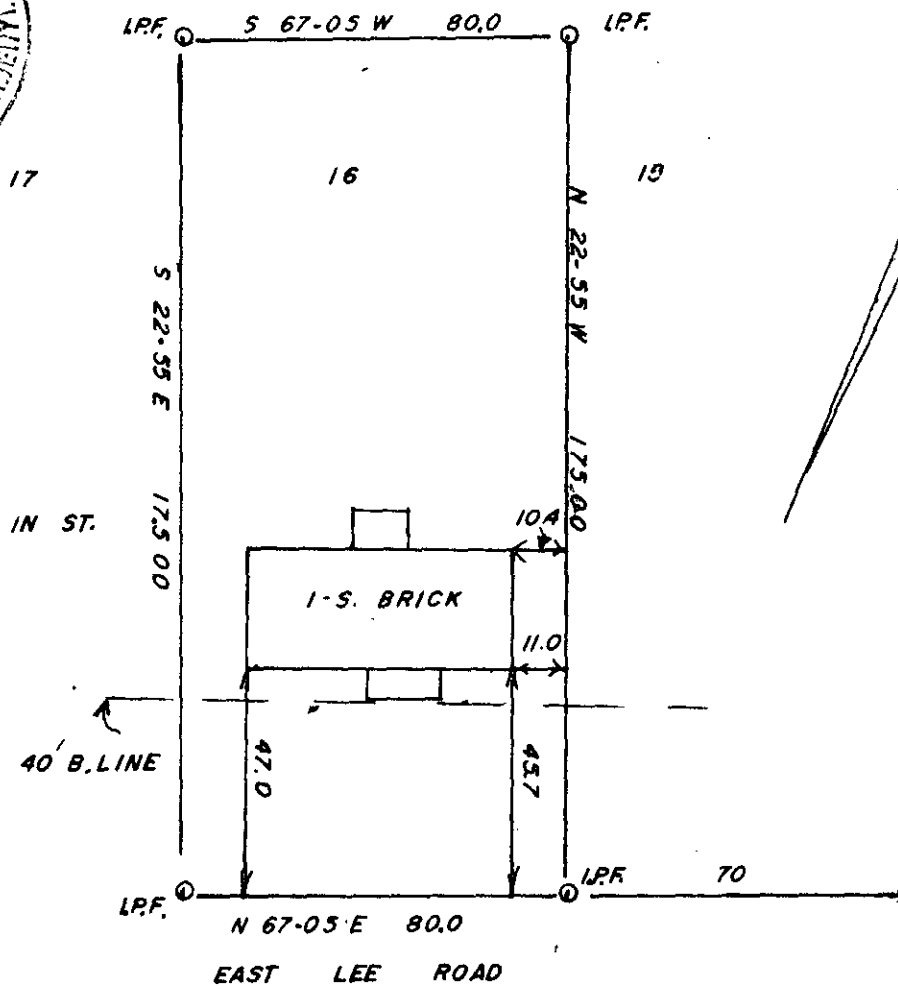

LIVE OAK WAY


23481

JAMES D WYATT and CONNIE WYATT

✓ 9-0-39

FILED
GREENVILLE CO. S. C.
MAR 17 3 35 PM '83
CONNIE S. TANKERSLEY,
R.M.C.

THIS IS TO CERTIFY THAT ON THE 15 DAY OF MARCH 1983, I SURVEYED THE PROPERTY SHOWN ON THIS PLAT, BEING KNOWN AS LOT 16 ON PLAT OF DAKWOOD ACRES, AND RECORDED IN THE R. M. C. OFFICE GREENVILLE COUNTY, S. C. IN PLAT BOOK M M AT PAGE 135; AND THAT THE PROPERTY LINES, WALLS, AND BUILDINGS ARE SHOWN HEREON, AND THAT THE WALLS AND BUILDINGS LOCATED ON SAID LOT DO NOT ENCR OACH OR PROJECT ON ADJACENT STREETS OR PROPERTY, AND THAT NO ADJACENT WALLS OR BUILDINGS ENCR OACH OR PROJECT ON SAID PREMISES, AND NO POWER LINES CROSS THIS PROPERTY EXCEPT AS SHOWN HEREON.

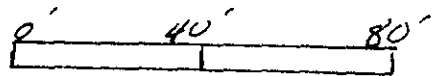

"THIS IS TO CERTIFY THAT THE ERROR OF CLOSURE OF THIS SURVEY IS 1 IN 10,000 ±, AND THE ACREAGE HAS BEEN DETERMINED BY THE D.M.D. METHOD."

