



This is to certify that on March 24, 1983, I surveyed the property shown on this plat, known as Lot 24 on the Plat of Richmond Hills, Sec. 27 the onded in the RMC Office of Greenville County in Plat Book JJJ on page 81, and that the property lines, walls and buildings are as shown hereon; that the building located on said lot does not encroach or project on adjacent streets or property, and that no adjacent walls or buildings encroach or project on said premises, and that no utility lines cross this property except as shown hereon. This property is not located in a designated flood hazard

area.

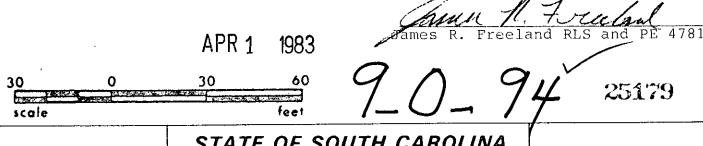

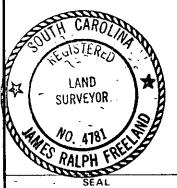

STATE OF SOUTH CAROLINA GREENVILLE COUNTY

RICHMOND HILLS SEC. 2; 107 24 PROPERTY OF STEVEN E. BLAKENEY L. BLAKENEY DONNA

FREELAND & ASSOCIATES

Engineers • Land Surveyors

GREENVILLE, S.C.

SURVEY M.L.C.	
DRAWN B.R.	
CHECK MC	
SCALE /" = 30	
DATE MARCH 2	24.83
DWG, NO. 8526	•