
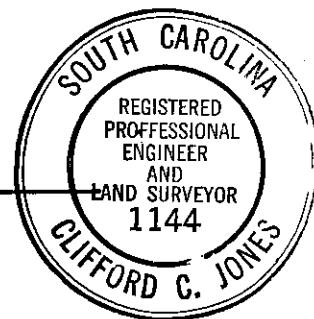


FILED
GREENVILLE CO. S. C.
APR 4 11 17 AM '83
DONNIE S. TANKERSLEY
R.M.C.

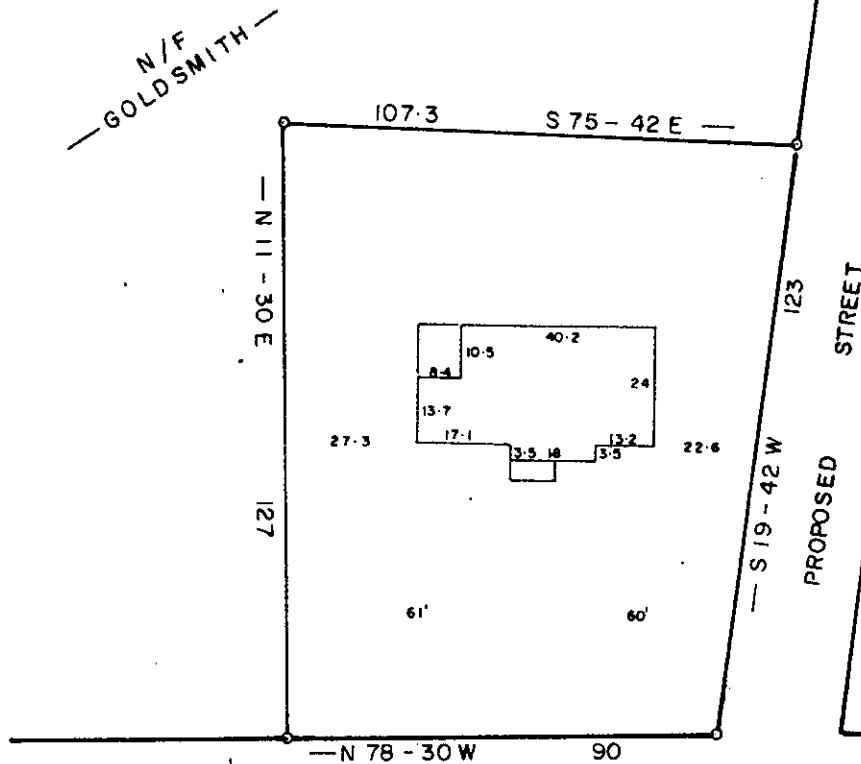

COURTNEY CIRCLE

NOTE: This lot does not lie in a flood plane.

APR 4 1983

25347 ✓ 9-P-4

PROPERTY OF
MARK A. EAST
JUDITH S. EAST
GREENVILLE COUNTY, S. C.

MARCH - 31 - 1983



Reg. Engineer No. 1144 S.C.



C., and that the property lines, walls and buildings are as shown hereon; that the buildings located on said lot do not encroach or project on adjacent streets or property; and that no adjacent buildings or walls encroach or project on said premises, and that no utility lines cross this property.