

This is to certify that on January 3, 1983, I surveyed the property shown on this plat, known as 1.6 acres on a portion of the property known as the Frank R. Washick Property, and that the property lines, walls and buildings are as shown hereon; and that no adjacent walls or buildings encroach or project on said premises, and that no utility lines cross this property except as shown hereon. This property is no located in a designated flood hazard area.

James R. Freeland
James R. Freeland PLS and PE 4781

FILED
GREENVILLE CO. S.C.

APR 6 10 36 AM '83



DONNIE S. TANKERSLEY
R.M.C.

APR 6 1983

25779

✓ 9-P-10

SPTS - 2 AP 6 1983 3:00 PM

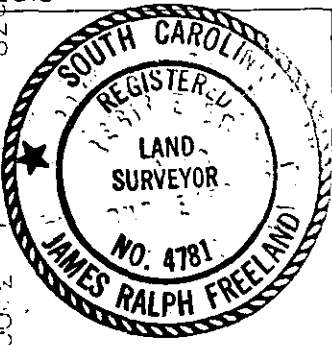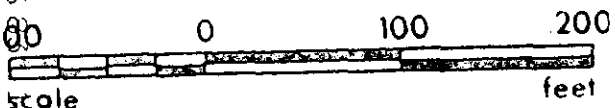

STATE OF SOUTH CAROLINA
GREENVILLE COUNTY

FREELAND & ASSOCIATES
Engineers • Land Surveyors

GREENVILLE, S.C.

PROPERTY OF
FRANK R. WASHICK

SURVEY D.C.H.

DRAWN B.R.

CHECK M.C.

SCALE 1" = 100'

DATE JAN. 3, 1983

DWG. NO. 8241