


FILED
 GREENVILLE CO. S.C.
 APR 7 1 59 PM '83
 DONNIE S. TANKERSLEY
 R.M.C.

This is to certify that on April 5, 1983, I surveyed the property shown on this plat, known as Lot 91 on the plat of Victor - Monaghan Mills, recorded in the RMC Office of Greenville County in Plat Book S on page 179, and that the property lines, walls and buildings are as shown hereon; that the building located on said lot does not encroach or project on adjacent streets or property, and that no adjacent walls or buildings encroach or project on said premises, and that no utility lines cross this property except as shown hereon. This property is not located in a designated flood hazard area.

James R. Freeland
 James R. Freeland PE and RLS 4781

9-P-23 ✓

APR 7 1983 25964

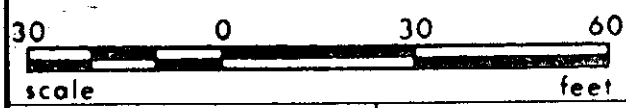

300 8 31541801



SEAL

STATE OF SOUTH CAROLINA
 GREENVILLE COUNTY

VICTOR-MONAGHAN MILLS
 LOT 91
 PROPERTY OF
 RANDY WARDLAW

FREELAND & ASSOCIATES
 Engineers • Land Surveyors

GREENVILLE, S.C.

SURVEY	BH
DRAWN	KEG
CHECK	<i>mt</i>
SCALE	1" = 30'
DATE	APRIL 5, 1983
DWG. NO.	8699