

FILED
GREENVILLE CO. S. C.
APR 8 2 06 PM '83
DONNIE S. TANKERSLEY
R.M.C.

This is to certify that on March 26, 1983, I surveyed the property shown on this plat, known as Lot 86 on the plat of Sans Souci Heights, recorded in the RMC Office of Greenville County in Plat Book Y on page 25, and that the property lines, walls and buildings are as shown hereon; that the building located on said lot does not encroach or project on adjacent streets or property, and that no adjacent walls or buildings encroach or project on said premises, and that no utility lines cross this property except as shown hereon. This property is not located in a designated flood hazard area.

9 P-28

James R. Freeland
James R. Freeland RLS and PE 4781


APR 8 1983 26054



**STATE OF SOUTH CAROLINA
GREENVILLE COUNTY**

FREELAND & ASSOCIATES
Engineers • Land Surveyors

GREENVILLE, S.C.

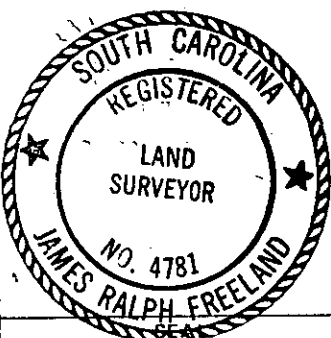

SANS SOUCI HEIGHTS
LOT 86
PROPERTY OF
K. MICHAEL DOCKINS
KATHY S. DOCKINS

SURVEY JC
DRAWN KEG
CHECK MLC
SCALE 1"=30'
DATE 3-26-83
DWG. NO. 8636

SOUTH CAROLINA 2 APR 8 1983 040 5.0001