


FILED
GREENVILLE CO. S. C.


APR 12 9 05 AM '83

DONNIE S. TANKERSLEY
R.M.C.

LOT 585 REVISED

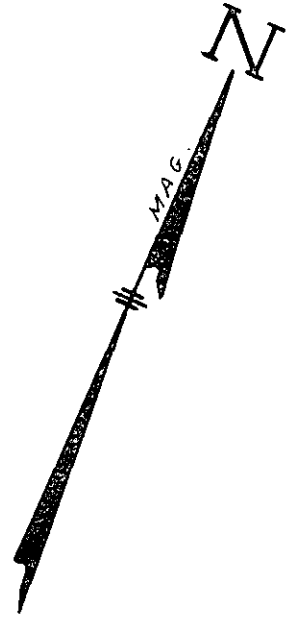

SUGARFIELD CT.

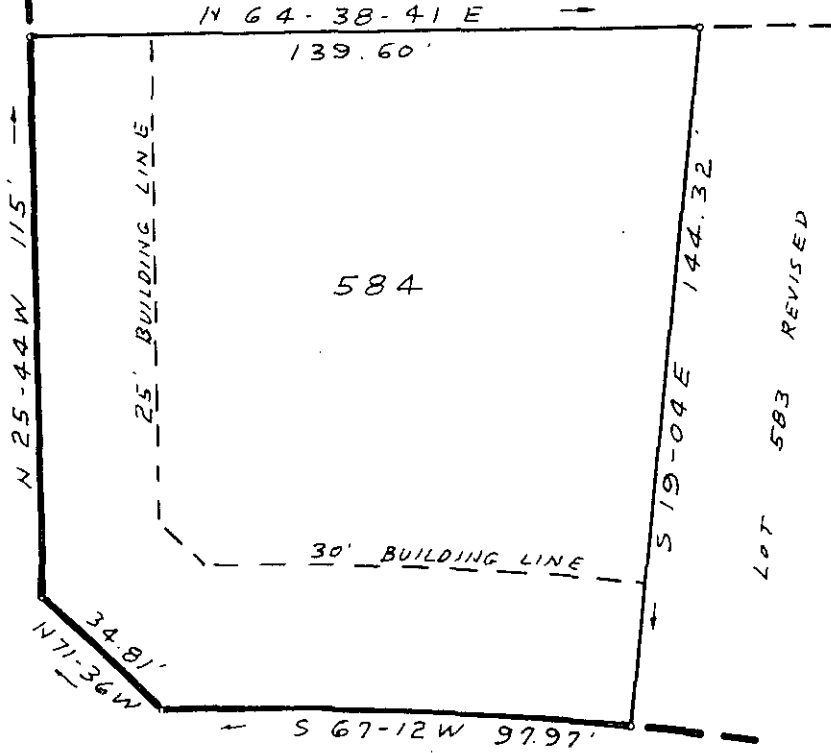

584

LOT 583 REVISED

26437

STONE CREEK RD.

9-P-36 ✓

APR 12 1983

REF. MAP 1, SECTION 3
SUGAR CREEK, RECORDED
IN PLAT BOOK 9F, PAGE 35.

NOTE: DRAINAGE AND UTILITIES
EASEMENT 5' EACH SIDE OF
SIDE AND REAR LOT LINES.

REVISION - LOT 584 - MAP 1 - SEC. 3

SUGAR CREEK


NEAR GREENVILLE S.C.

SCALE 1" = 40'

MAR. 31, 1983

C. O. Riddle

RLS #1397 Greenville, S.C.

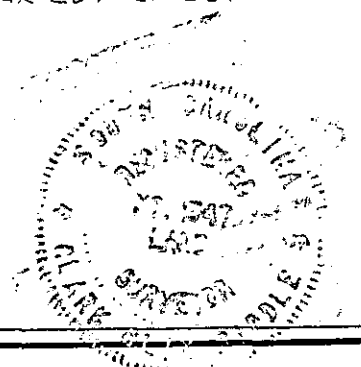

10811326 000 0 32271001