


291 BYPASS
WATER & SEWER IN ST. RIW

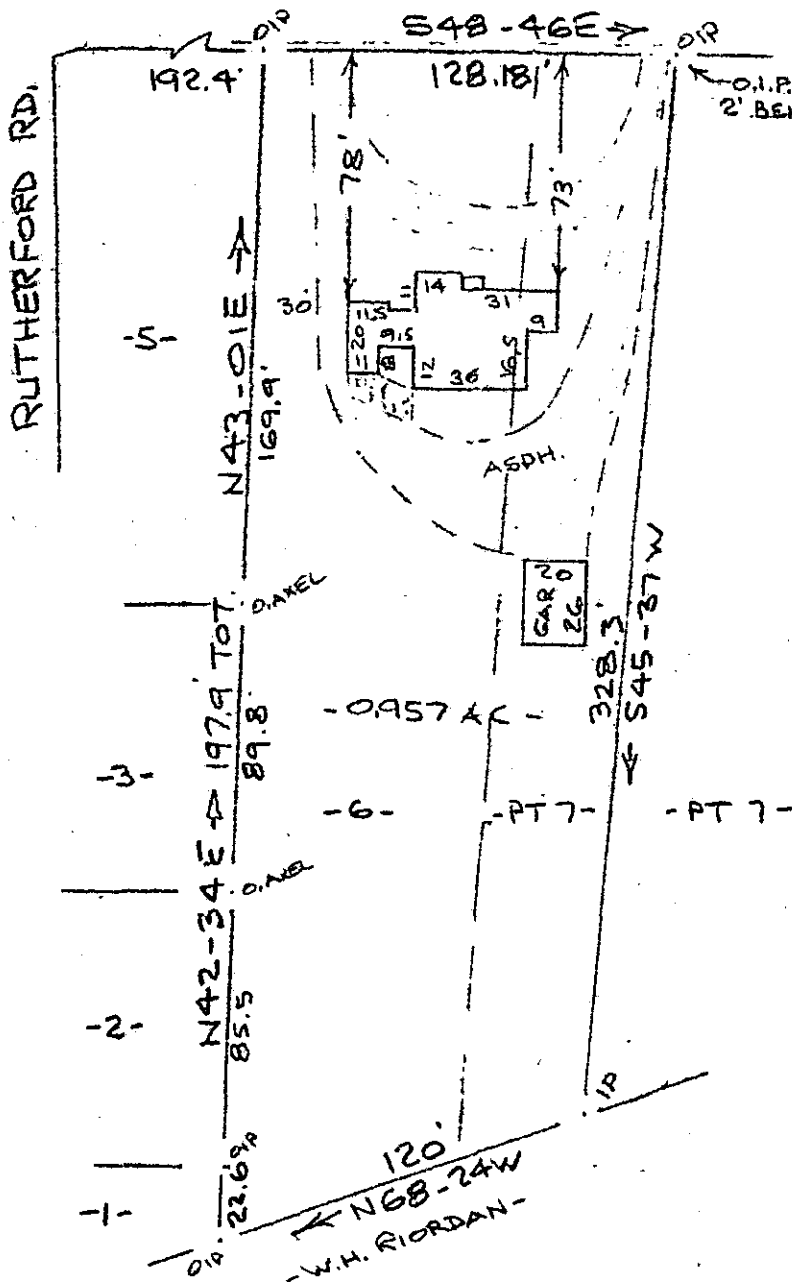

FILED
GREENVILLE CO. S. C.

APR 22 9 21 AM '83

DONNIE S. TANKERSLEY
R.M.C.

PROPERTY OF
WILLIAM H. MYERS
GREENVILLE, S. C.
60' 21 APR 1983 60'

Note: Improvements
on this lot are not
in a flood hazard
area.

APR 22 1983

9 P - 7627647

This is to certify that on the 21st day of April, 1983, I surveyed the property shown on this plat, being known as lot 6 and part of lot 7 on plat of WHITE OAK SUBDIVISION and recorded in the RMC Office Greenville County, S. C., in Plat Book " P " at Page 121; and that the property lines, walls and buildings are as shown hereon, and that the walls and buildings located on said lot do not encroach or project on adjacent street or property, and that no adjacent walls or buildings encroach or project on said premises, and no power lines cross this property except as shown hereon. Also being known as PROPERTY OF WILLIAM H. MYERS and recorded in Plat Book at Page

R. B. Bruce
R. B. Bruce, RLS # 1952