MICROFILMED

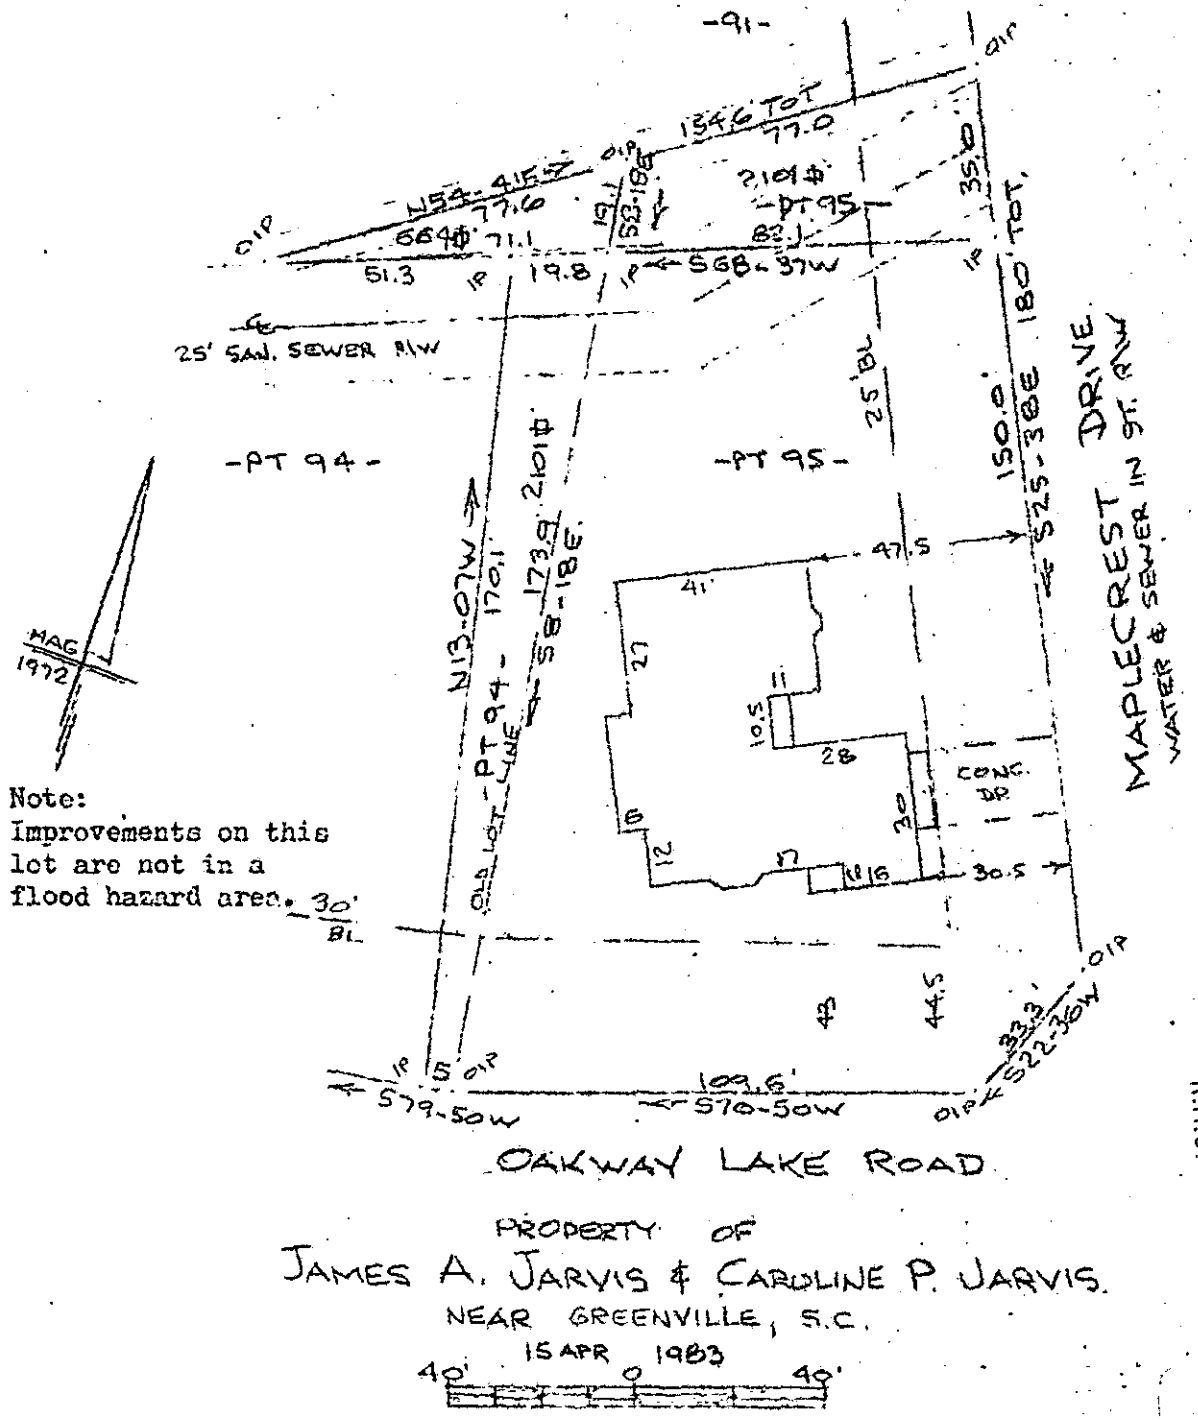

Note:
Improvements on this lot are not in a flood hazard area.

PROPERTY OF
JAMES A. JARVIS & CAROLINE P. JARVIS
NEAR GREENVILLE, S.C.
15 APR 1983
40' 0 40'

FILED
GREENVILLE CO. S.C.
APR 25 10 19 AM '83
DONNIE S. TANKERSLEY
R.M.C.

This is to certify that on the 15th day of April, 1983, I surveyed the property shown on this plat, being known as part of lot 95 and part of lot 94 on plat of DOVE TREE recorded in the RMC Office Greenville County, S. C., in Plat Book " 4 - X " at Pages 21 - 23 and also being known as PROPERTY OF JAMES A. JARVIS & CAROLINE P. JARVIS and recorded in Plat Book at Page ; and that the property lines, walls and buildings are as shown hereon, and that the walls and buildings located on said lot do not encroach or project on adjacent street or property, and that no adjacent walls or buildings encroach or project on said premises, and no power lines cross this property except as shown hereon.

9-P-84

27809

APR 25 1983

R. B. Bruce

R. B. Bruce, RLS #1952

CAROLINA SURVEYING CO.
112 Manly St.
Greenville, S. C.

251/24 540.10-1-94