



MICROFILME

FILED  
GREENVILLE CO. S. C.  
APR 28 9 59 AM '83  
DONNIE S. TANKERSLEY  
R.M.C.

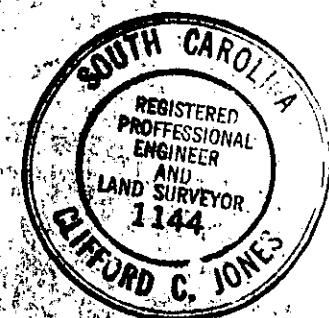

WARDLAW STREET

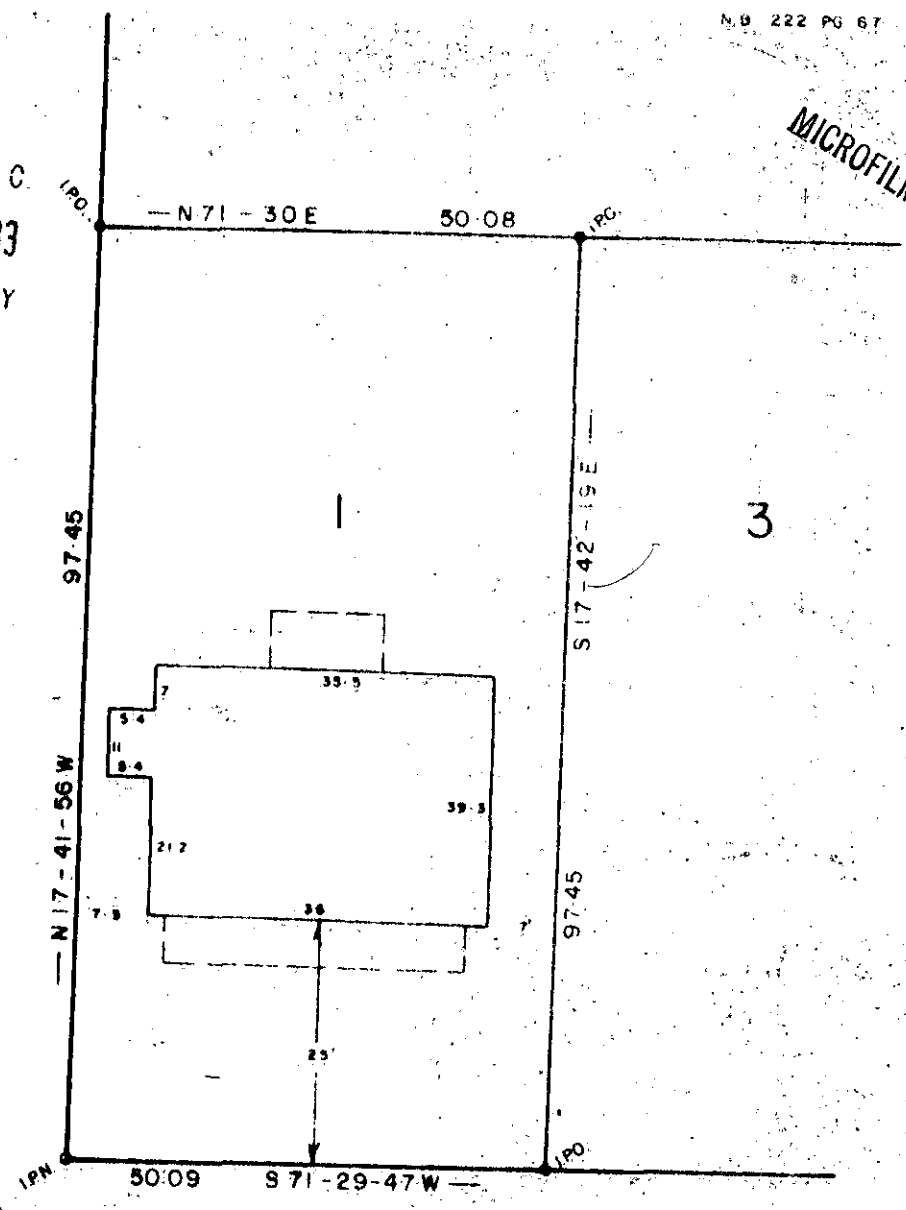

LOGAN STREET

NOTE: THIS LOT DOES NOT LIE IN A FLOOD PLANE.

✓ 9P-97


APR 28 1983

28282

PROPERTY OF  
PETER J. EMANUEL



GREENVILLE, S. C.  
APRIL - 18 - 1983

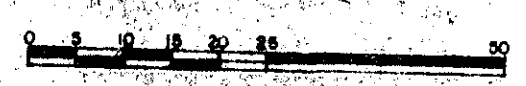

*Clifford C. Jones*  
Eng. No. 1144

2 AP28 83. 701 3.20CI