

FILED
 GREENVILLE CO. S. C.
 APR 28 12 02 PM '83
 DONNIE S. TANKERSLEY
 R.H.C.


APR 28 1983

9-P-100 28280

WATERS AVE.

This is to certify that on April 26, 1983, I surveyed the property shown on this plat, known as Lot 9 on the plat of Pickwick Heights, recorded in the S.C. Office of Greenville County in Plat Book X on page 141 and that the property lines, walls and buildings are as shown hereon; that the building located on said lot does not encroach or project on adjacent streets or property and that no adjacent walls or buildings encroach or project on said premises, and that no utility lines cross this property except as shown hereon. This property is not located in a designated flood hazard area.

James R. Freeland
 James R. Freeland PE and RLS-4781

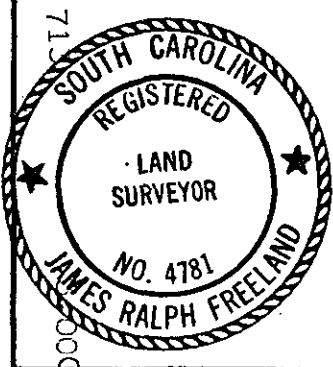

STATE OF SOUTH CAROLINA
 GREENVILLE COUNTY

PICKWICK HEIGHTS
LOT 9
PROPERTY OF
KATHRYN M. CURRY

FREELAND & ASSOCIATES Engineers • Land Surveyors
GREENVILLE, S.C.
SURVEY J.C.
DRAWN B.R.
CHECK <i>JRF</i>
SCALE 1" = 30'
DATE APRIL 26, 83
DWG. NO. 8843