


MICROFILMED

MICROFILMED


FILED
GREENVILLE CO. S.C.
AUG 2 9 06 AM '83
DONNIE S. TANKERSLEY
R.M.C.

FILED
GREENVILLE CO. S.C.
AUG 2 9 06 AM '83
DONNIE S. TANKERSLEY
R.M.C.

AUG 2 1983

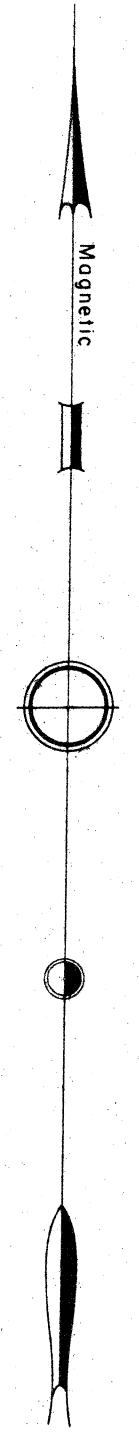

AUG 2 1983

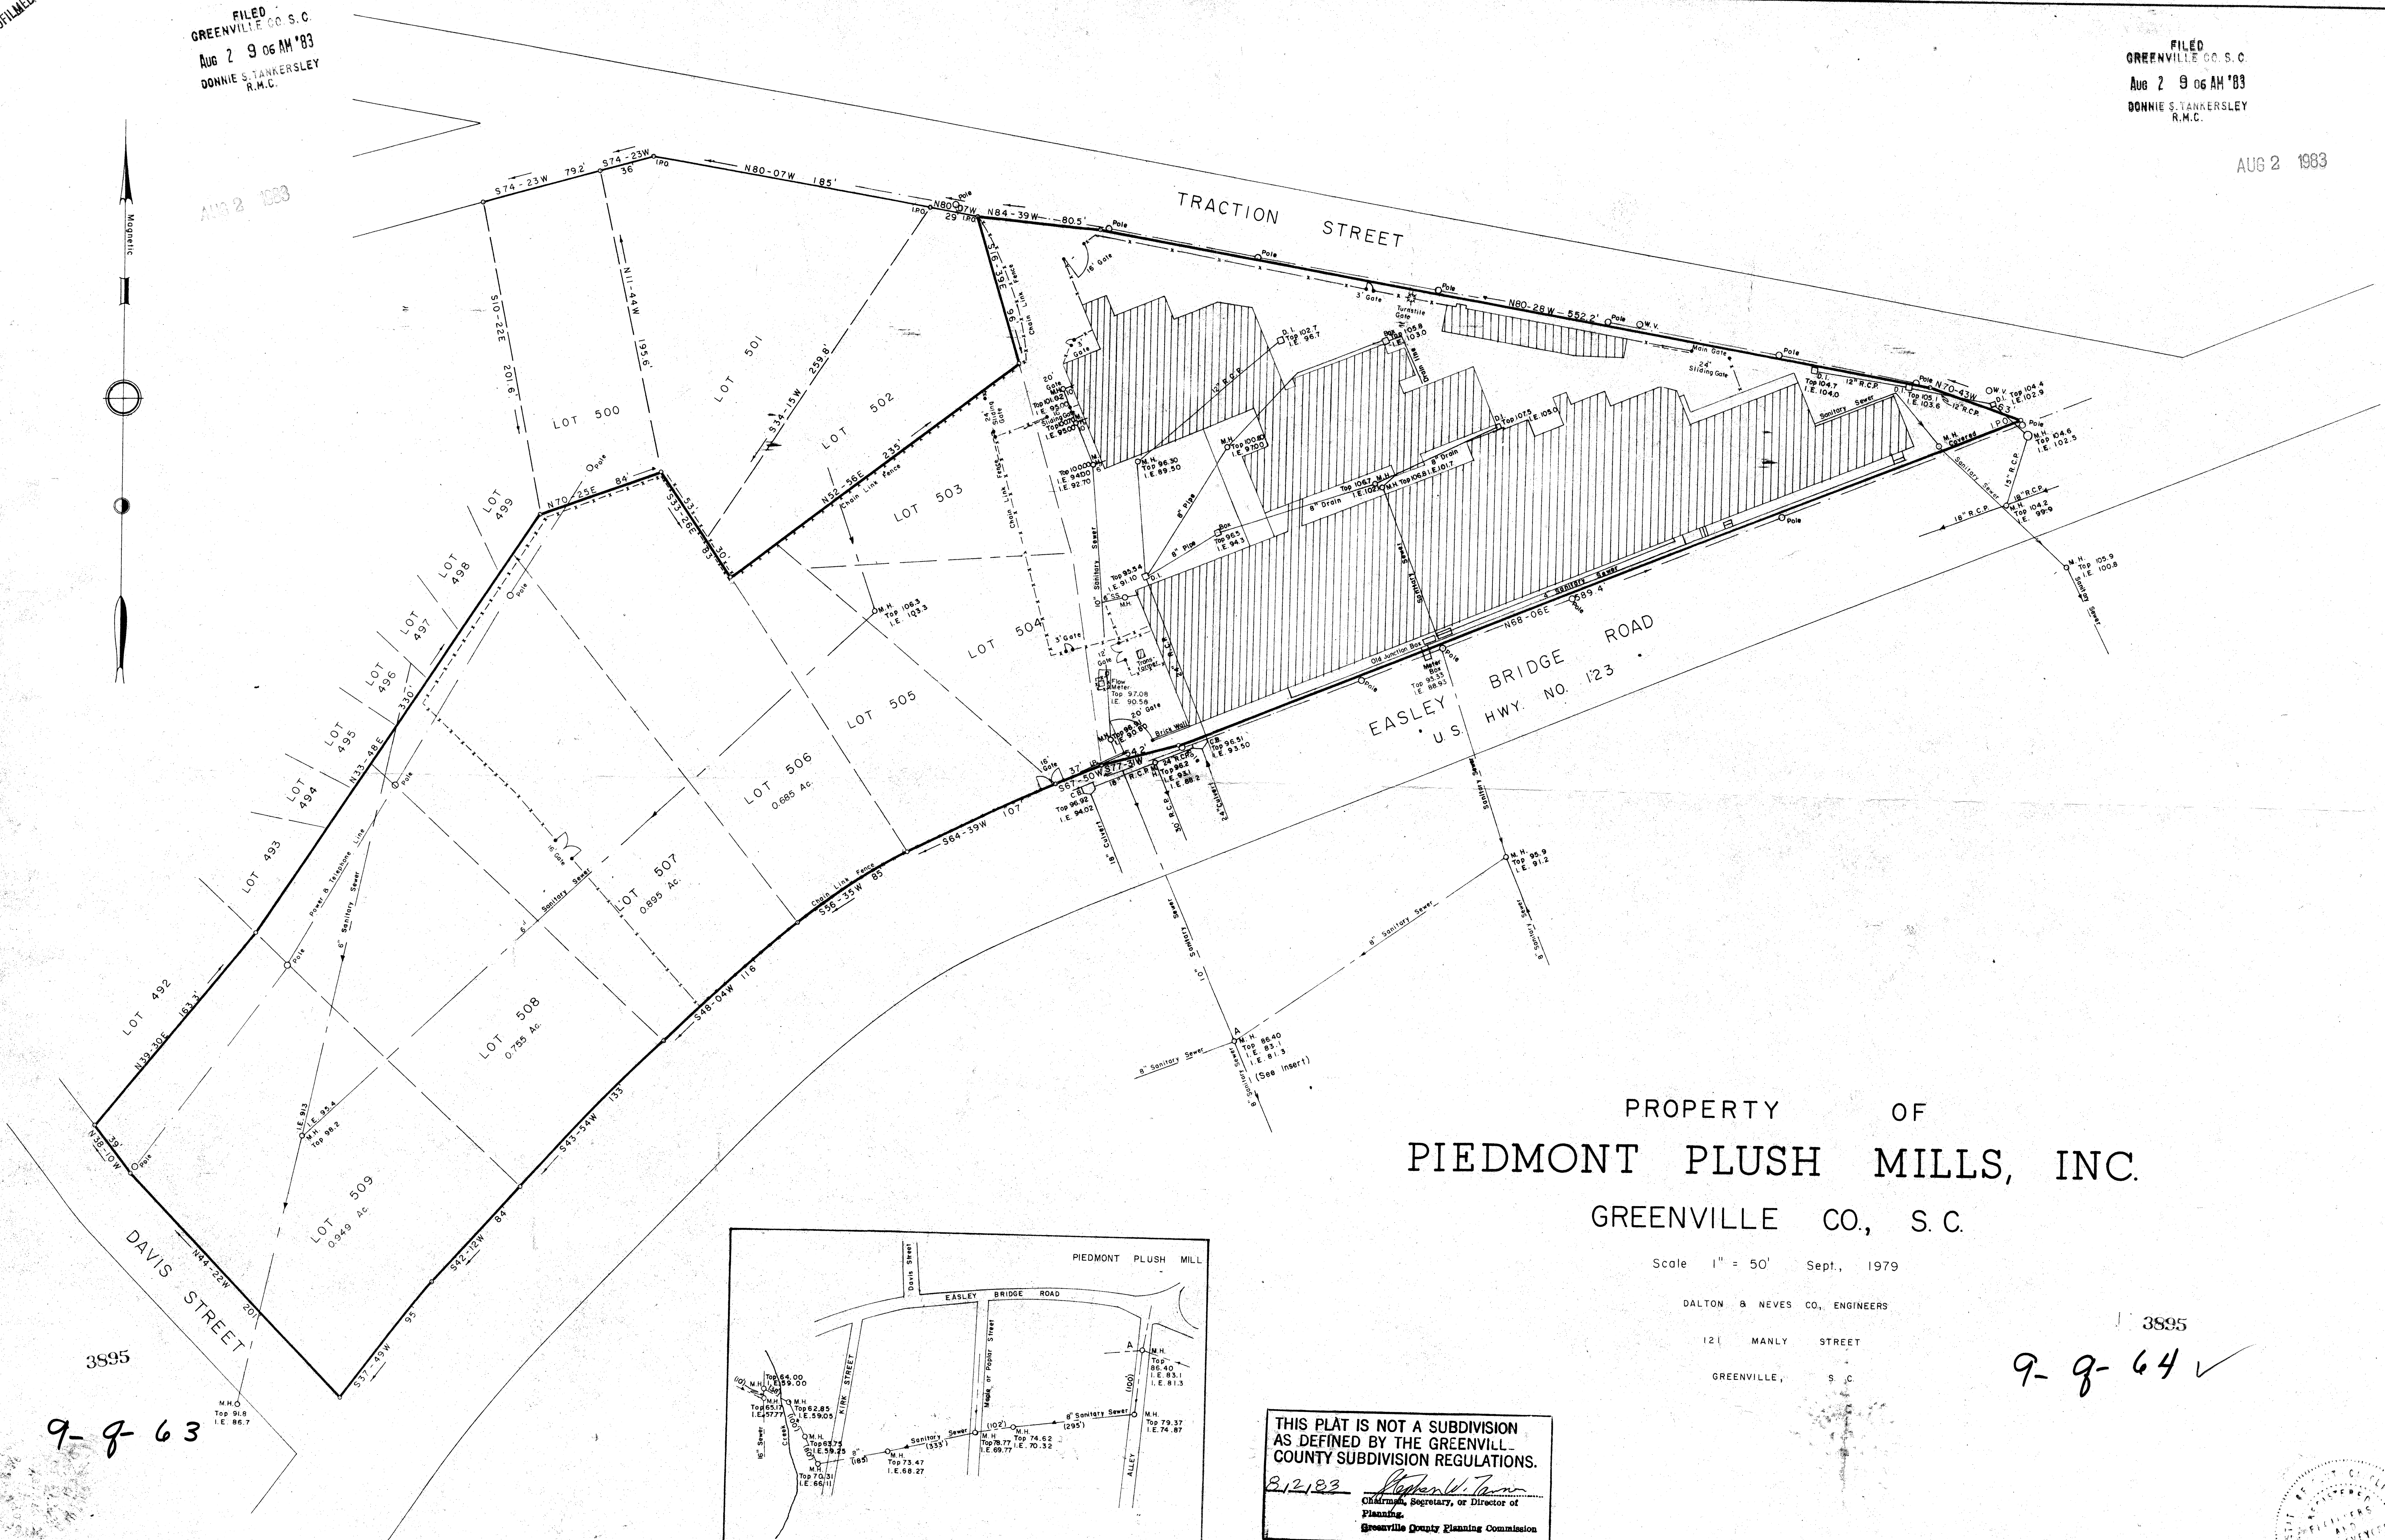


PROPERTY OF
PIEDMONT PLUSH MILLS, INC.
GREENVILLE CO., S.C.

Scale 1" = 50' Sept., 1979

DALTON & NEVES CO., ENGINEERS
121 MANLY STREET
GREENVILLE, S.C.

3895

9-9-64 ✓

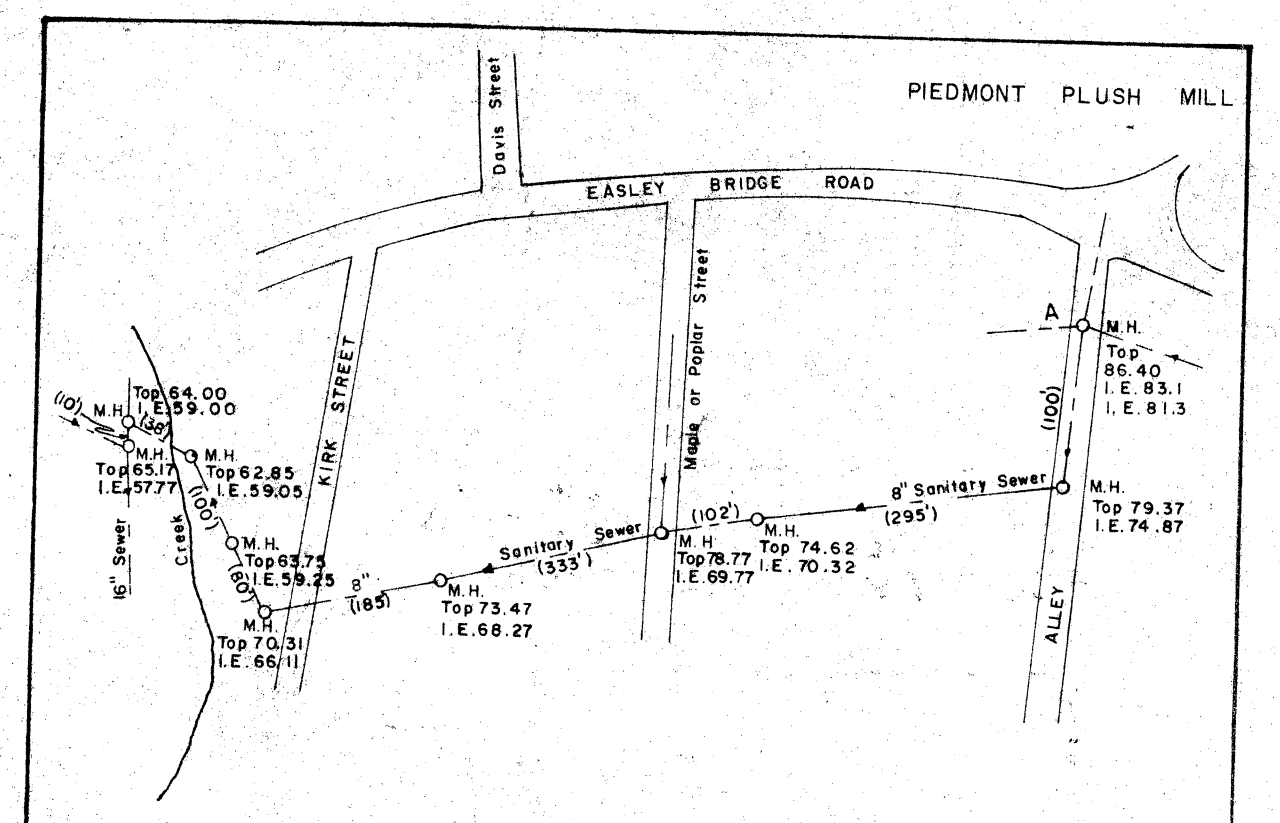

THIS PLAT IS NOT A SUBDIVISION
AS DEFINED BY THE GREENVILLE
COUNTY SUBDIVISION REGULATIONS.
8/2/83 *Stephen W. Tamm*
Chairman, Secretary, or Director of
Planning,
Greenville County Planning Commission

