


MICROFILMED

ELBIE SCOOTER


122

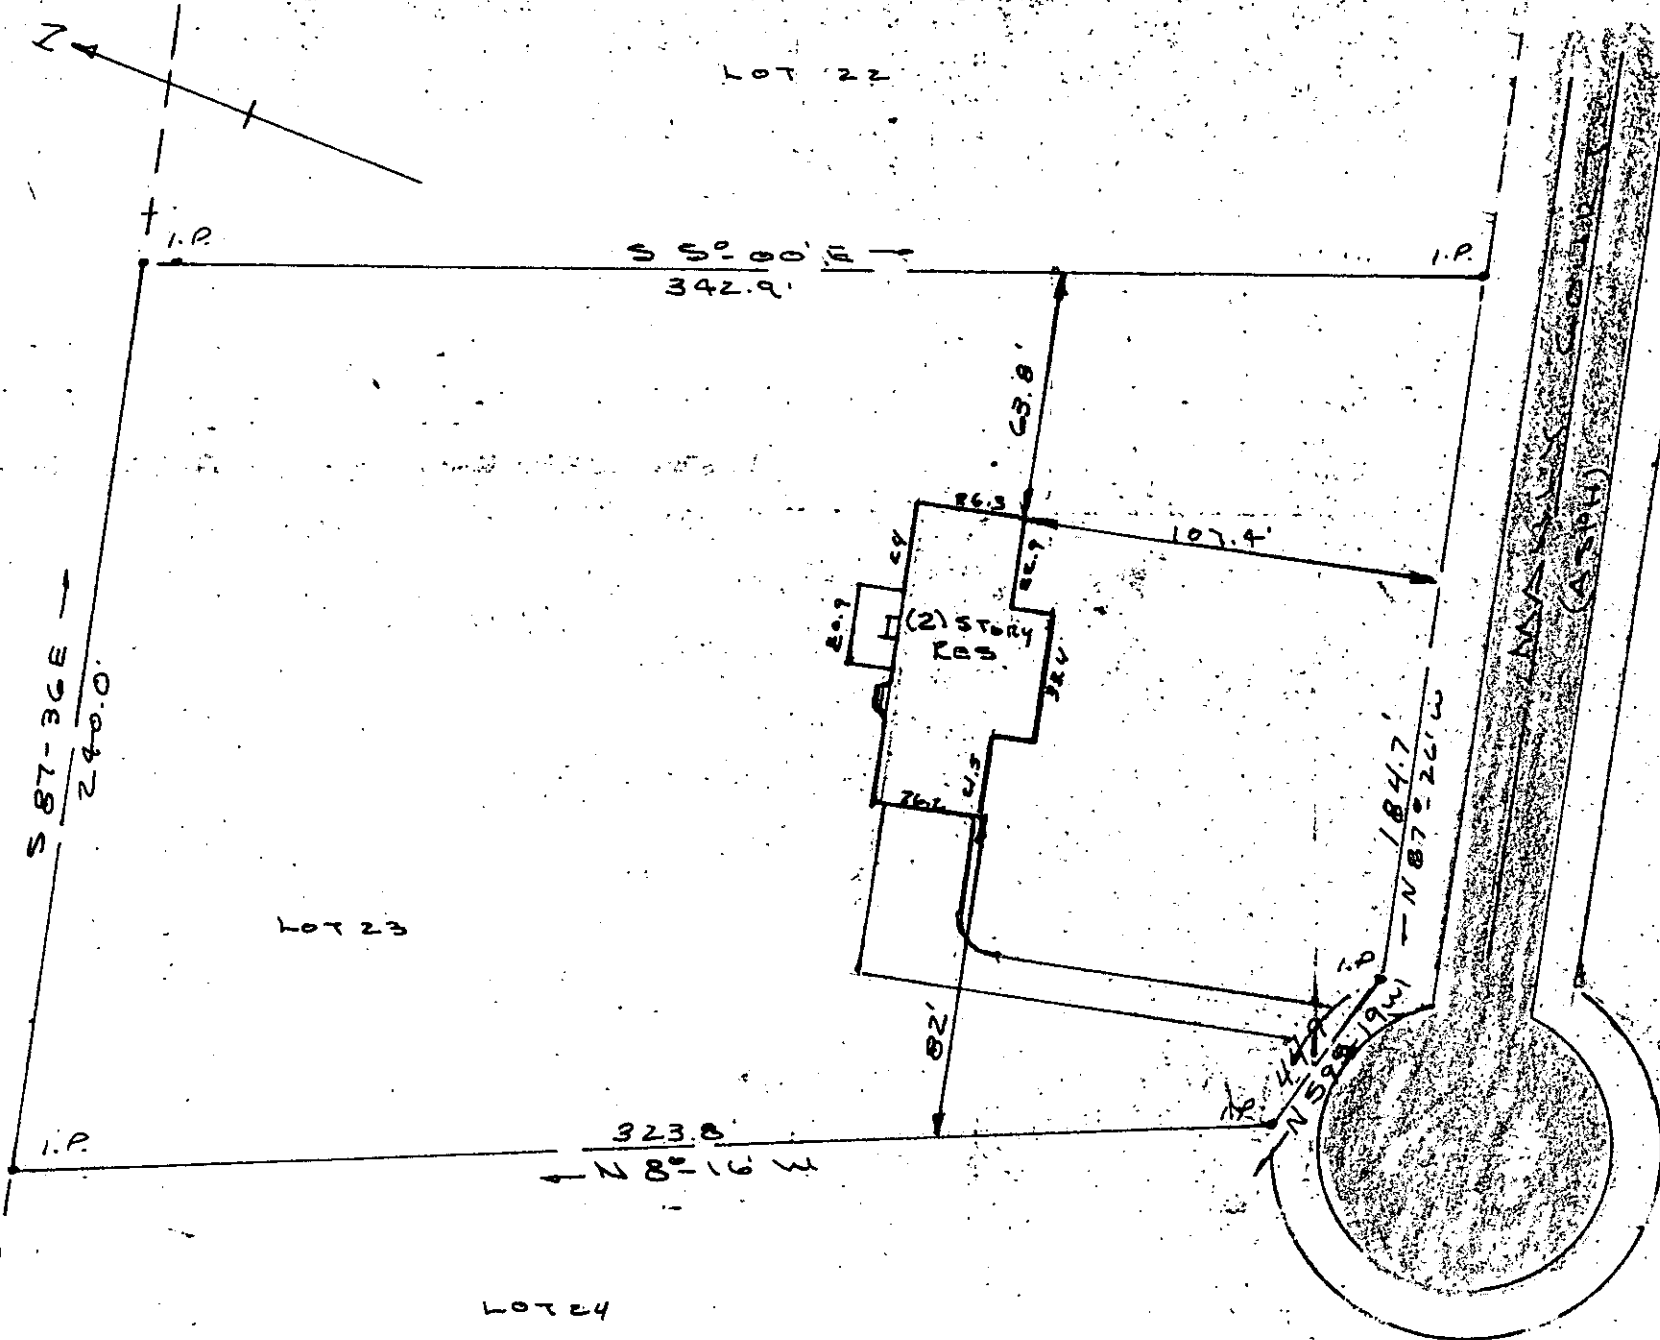

5' DRAINAGE BASEMENT BA. SIDE OF REAR & SIDE LOT LINES.
 U.G. POWER & TEL. WATER IN STREET & SEPTIC TANK.


CAMERON WOODS

GREENVILLE COUNTY
 ONEAL TOWNSHIP
 GREEN, S.C.
 (OFF. FEWS CHAPEL RD.)

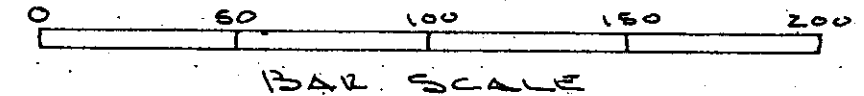

FILED
 GREENVILLE CO. S.C.
 MAY 23 8 52 AM '83
 DONNIE S. TARKERSLEY
 R.M.C.

I CERTIFY THE ABOVE LOT HAS BEEN SURVEYED AND IS AS SHOWN TO THE BEST OF MY KNOWLEDGE. THERE ARE NO ENCROACHMENTS & LOT IS NOT LOCATED IN A FLOOD PLAIN AREA

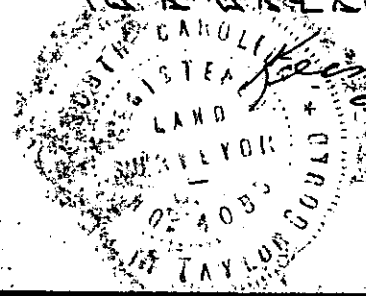

K. T. Gould
 S.C. REG. NO. 4035

9-R-37 31198

PROPERTY OF JACK H. JR & KATHY H. OSHIELDS		
SCALE: 1" = 50'	APPROVED BY	DRAWN BY K.T.G.
DATE: 5-13-83		
K.T. GOULD INC. - SURVEYORS - TAXIDORS, S.C.		
LOT 23, 1.81 ± AC.		DRAWING NUMBER