


This is to certify that on May 30, 1983, I surveyed the property shown on this plat, known as Lot 7 on the plat of Standing Springs (Sec. 1), recorded in the REC Office of Greenville County in Plat Book WWW on page 49 and that the property lines, walls and buildings are as shown hereon; that the building located on said lot does not encroach or project on adjacent streets or property, and that no adjacent walls or buildings encroach or project on said premises, and that no utility lines cross this property except as shown hereon. This property is not located in a designated flood hazard area.

JUN 1 1983

32478 James R. Freeland  
James R. Freeland PLS & PE 4781

9-R-46

FILED  
GREENVILLE CO. S.C.  
JUN 1 10 37 AM '83  
DONNIE S. TANKERSLEY  
R.M.C.

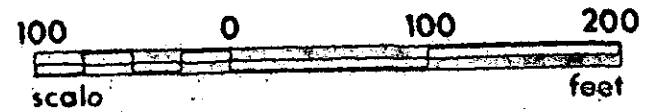

TX. BK. 574.2-1-32



STATE OF SOUTH CAROLINA  
GREENVILLE COUNTY

STANDING SPRINGS  
SEC. 1; LOT 7  
PROPERTY OF  
J. EDWIN BARTON  
BARBARA BARTON

FREELAND & ASSOCIATES  
Engineers • Land Surveyors

GREENVILLE, S.C.

SURVEY	F.T.
DRAWN	K.E.G.
CHECK	RP
SCALE	1" = 100'
DATE	5-30-83
DWG. NO.	9050