


MICROFILMED

Notes:
Improvements on
FILED's lot are not
GREENVILLE 005003 hazard
area.

APR 27 11 10 AM '83

DONNIE S. TANKERSLEY
R.M.C.

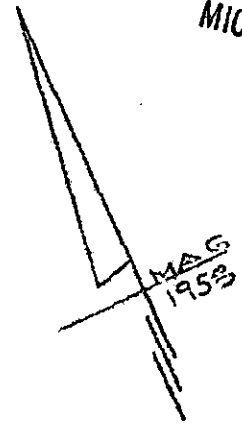

PROPERTY OF
ANTHONY H. WATERS

NEAR GREENVILLE, S.C.
100' 22 APR 1983 100'

Note: The subject property was
cut from the 21.36 acre tract
(T 21 - 1 - 19) owned by
Anthony H. Waters and closely
approximates the " 3.58 acres "
described in Book 553
Page 480, however we do not
certify this plat to be an
accurate resurvey of such
original 3.58 acre tract.

APR 27 1983 ✓

9-P 94
28177

ANTHONY H. WATERS
PRIVATE RD (GRAVEL)
30' 516-10W
536'



SEPTIC TANK

3.58 AC ±

507' 501
N 15.55 E
ANTHONY H. WATERS

150'
N 41-10 E
DIP

100' 130'
S 62-05 E → S 66-00 E
S.C. HWY 415 (HWY 290)

GC10 -----3 AP 27 83 074

3.00 CD

This is to certify that on the 22nd day of April, 1983, I surveyed the property
shown on this plat, being known as 3.58 acres on plat of ANTHONY H. WATERS ESTATE
and also known as PROPERTY OF ANTHONY H. WATERS and recorded in the R.M.C. Office
Greenville County, S. C., in Plat Book _____ at Page _____; and that the
property lines, walls and buildings are as shown hereon, and that the walls and
buildings located on said lot do not encroach or project on adjacent street or
property, and that no adjacent walls or buildings encroach or project on said
premises, and no power lines cross this property except as shown hereon.

R. B. Bruce, S.S. 1952

CAROLINA SURVEYING CO.
112 Mainly St.
Greenville, S.C.