


FILED
 GREENVILLE CO. S.C.
 APR 28 2 48 PM '83
 DONNIE S. JANKERSLEY
 R.M.C.

28279

9-5-2 ✓

WINCHESTER COURT

This is to certify that on April 28, 1983, I surveyed the property shown on this plat, known as Lot 5 on Oak Tree Plaza, recorded in the RMC Office of Greenville County in Deed Book 1002 page 134, and that the property lines, walls and buildings are as shown hereon; that the building located on said lot does not encroach or project on adjacent streets or property, and that no adjacent walls or buildings encroach or project on said premises, and that no utility lines cross this property except as shown hereon. This property is not located in a designated flood hazard area.

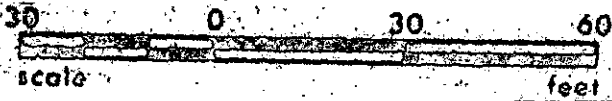

James R. Freeland
 James R. Freeland RLS & PE 4781



STATE OF SOUTH CAROLINA
 GREENVILLE COUNTY

FREELAND & ASSOCIATES
 Engineers • Land Surveyors
 GREENVILLE, S.C.

OAKTREE PLAZA
LOT 5
PROPERTY OF
EDGEWOOD INVESTORS
 APR 28 1983

SURVEY BH
 DRAWN KG
 CHECK JRF
 SCALE 1"=30'
 DATE 4-28-83
 DWG. NO. 8856