



This is to certify that on April 25, 1983, I surveyed the property shown on this plat, known as Lot 47 on plat of Gray Fox Run Sec. 1, recorded in the RMC Office of Greenville County in Plat Book 5P on page 9, and that the property lines, walls and buildings are as shown hereon; that the building located on said lot does not encroach or project on adjacent streets or property, and that no adjacent walls or buildings encroach or project on said premises, and that no utility lines cross this property except as shown hereon. This property is not located in a designated flood hazard area.

5' drainage and utility easement each side of all side and rear lot lines.

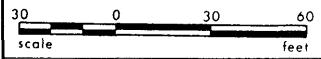

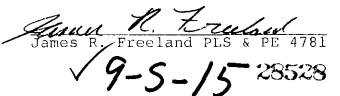

## STATE OF SOUTH CAROLINA GREENVILLE COUNTY

LAND SURVEYOR

GRAY FOX RUN

SEC. 1; LOT 47

PROPERTY OF

JAMES BARCLAY MILL

KAREN G. MILL

## FREELAND & ASSOCIATES Engineers • Land Surveyors

GREENVILLE, S.C.

SURVEY MLC. & 0.6.

DRAWN 3. R.

CHECK MLC

SCALE M= 30

DATE 4-25-83

DWG. NO. 8824

PRINT MACHINE INC

7685