
FILED GREENVILLE CO. S. C. REF PORTION OF PROPERTY (NIF) J.G. HENDESION-REC PMC SV.SE

1971 Mark

Note: Improvements on this lot are not in a flood hazard area.

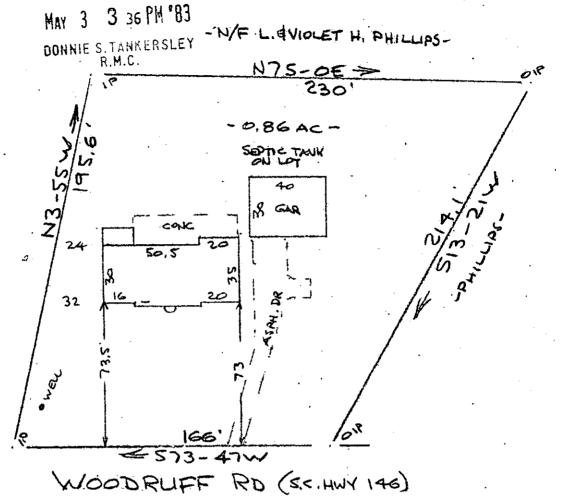

WILTON E. LAWRENCE & SYLVIA A. LAWRENCE MAY 3 1983

NEAR GREENVILLE, S.C. MAY 3 1983

SQ. 26APR 0 1983 50' 9-5-30'

This is to certify that on the 26th day of April, 1983, I surveyed the property shown on this plat, being known as 0.86 acre on plat of PROPERTY OF J. G. HENDERSON and recorded in the RMC Office Greenville County, S. C., in Plat Book " 5 - V" at Page 55 and also known as PROPERTY OF VILTON E. LAWRENCE & SYLVIA A. LAWRENCE and recorded in Plat Book at Page ; and that the property lines, walls and buildings are as shown hereon, and that the walls and buildings located on said lot do not encroach or project on adjacent street or property, and that no adjacent walls or buildings encroach or project on said premises, and no power lines cross this property except as shown hereon.

R. B. Bruce, RLS #1952

CAROLINA SURVEYING CO.

112 Manly St.

Greenville, S C300 3 36121A01