


FILED
GREENVILLE CO. S. C.
MAY 9 10 54 AM '83
DONNIE S. TANKERSLEY
R.M.C.

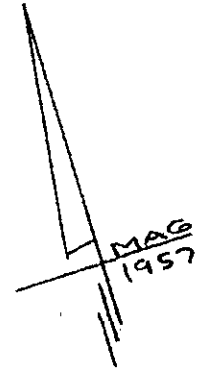

Note: Improvements on this lot are not in a flood hazard area.

PROPERTY OF
EDGAR JOHN JIMENEZ & DOROTHY B. JIMENEZ
NEAR GREENVILLE, S.C.

28 APR 1983
60' 0 60'

29483

This is to certify that on the 28th day of April, 1983, I surveyed the property shown on this plat, being known as lot 23 on plat of MAP OF RIVERDALE and recorded in the RMC Office Greenville County, S. C., in Plat Book "KK" at Page 107; and that the property lines, walls and buildings are as shown hereon, and that the walls and buildings located on said lot do not encroach or project on adjacent street or property, and that no adjacent walls or buildings encroach or project on said premises, and no power lines cross this property except as shown hereon.

9-5-48

R. B. Bruce
R. B. Bruce, RLS #1952

CAROLINA SURVEYING CO.
112 Manly St.
Greenville, S. C.

224
3.000