


Note: Drainage And Utility Easements 5' Either Side Of All Side Lot Lines, And 10' On Rear Lot Lines Except As Otherwise Noted Or Shown.


White Oak Hills, Phase II - A Plat-Book 7-C - Page 95.

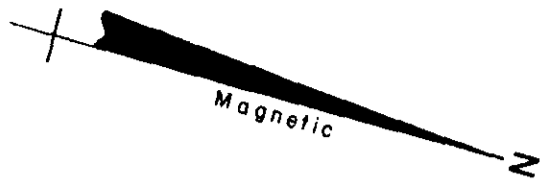

FILED
GREENVILLE CO. S.C.
MAY 23 1 05 PM '83
DONNIE S. TANKERSLEY
R.M.C.

- RICE -
20

A. J. PRINCE
BUILDERS, INC.

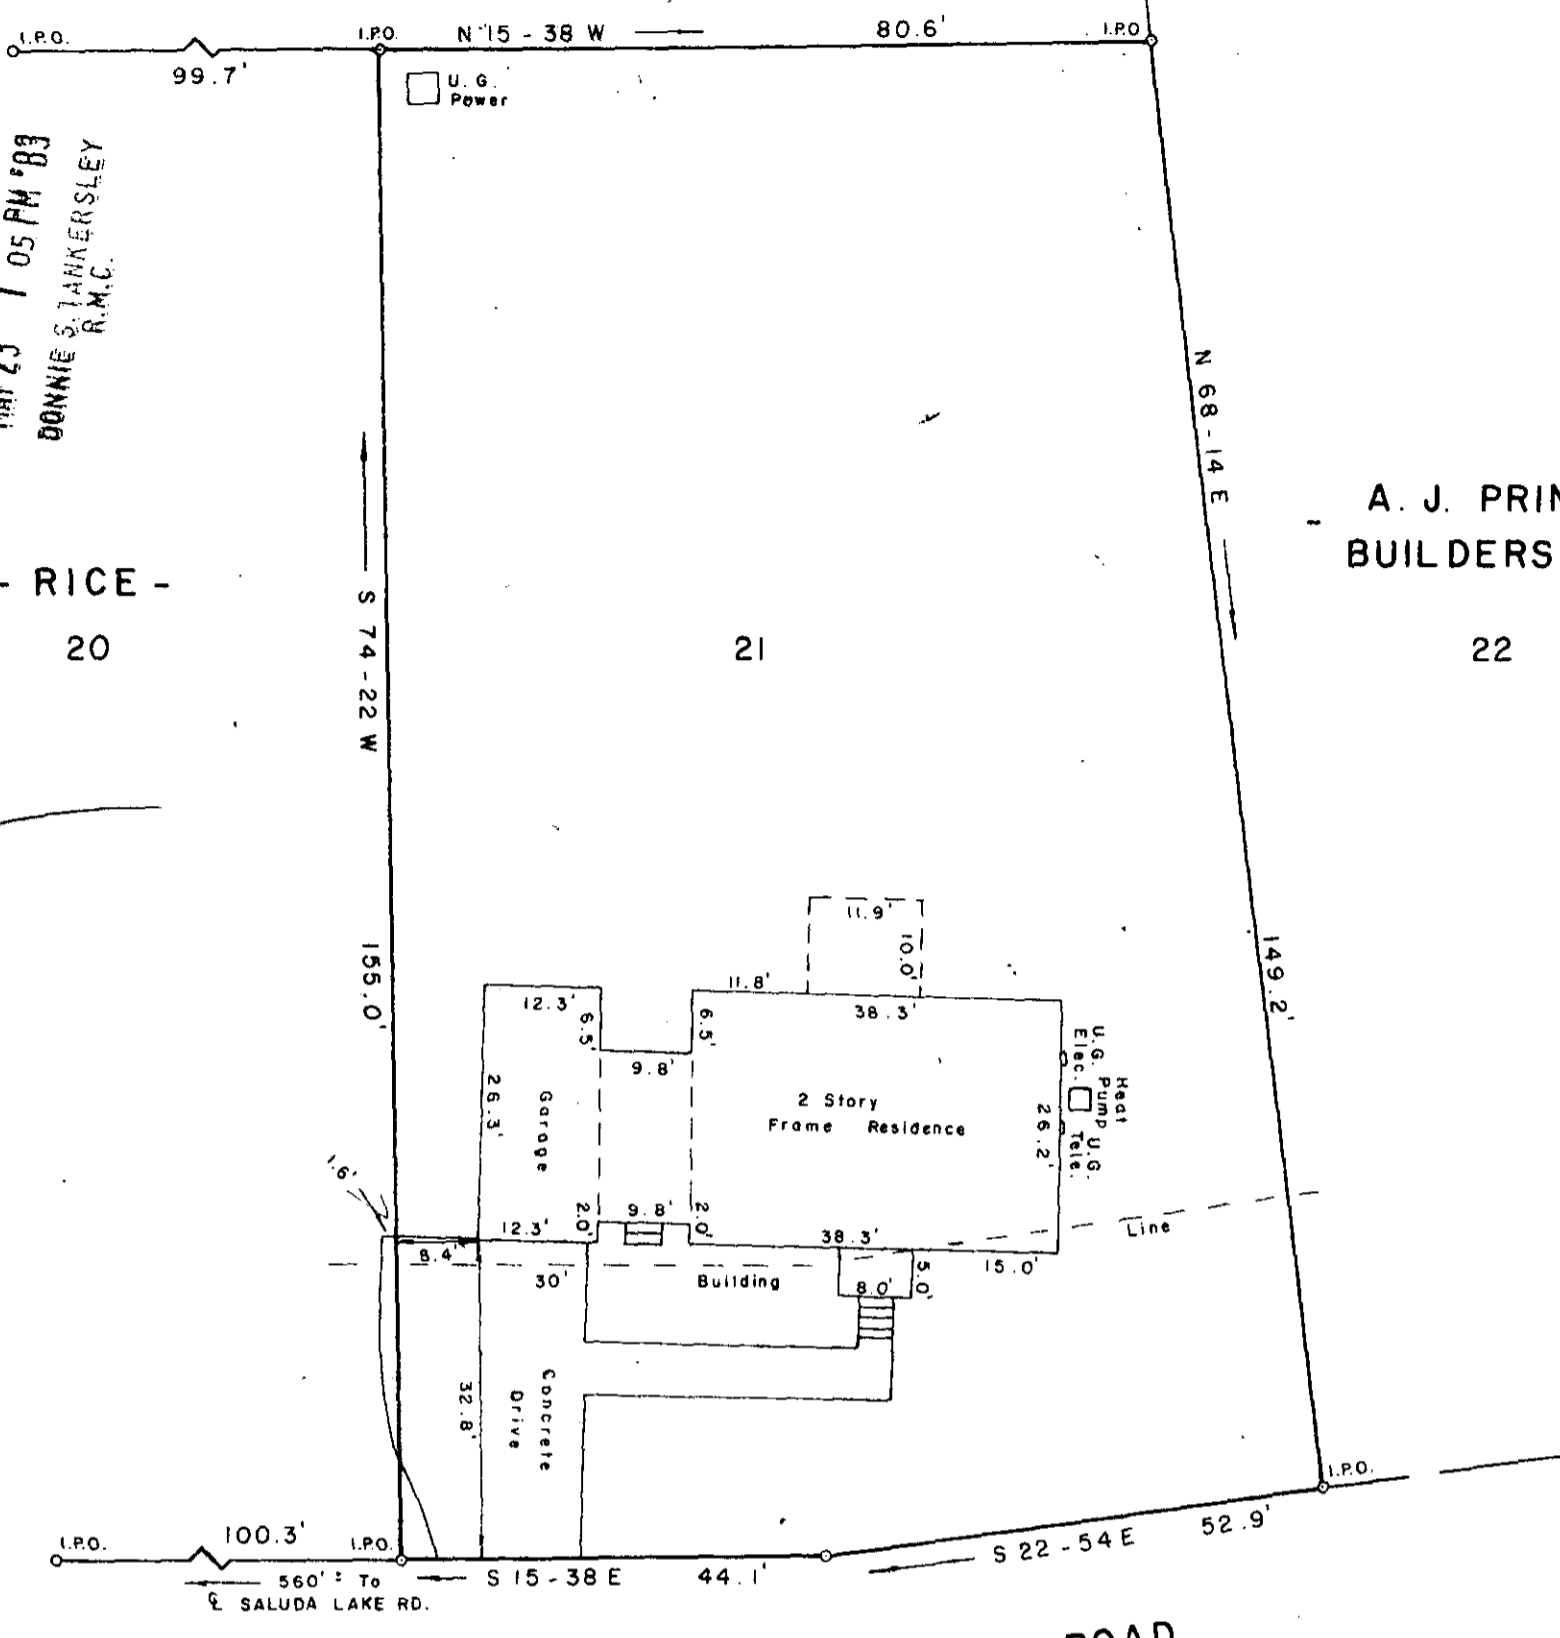

SURVEY FOR
SAMUEL D. WEAVER
MAGARET A. WEAVER

NEAR BEREA SOUTH CAROLINA
MAY 18, 1983

31196

MAY 23 1983 9-T - 1 ✓


To The Best Of My Knowledge This Structure Is Not In An Established Flood Zone.

I Heroby Certify That The Measurements As Shown Above Are Correct And There Are No Encroachments Or Projections Other Than Shown.


I Heroby Certify That The Ratio Of Precision Of The Field Survey Is 1/5000 As Shown Hereon And The Area Was Determined By D.M.D. Method.

JEFFERY M. PLUMBLEE, INC.
LAND SURVEYING

P. O. BOX 788 TRAVELERS REST, S. C. 29690 (803) 834-4426

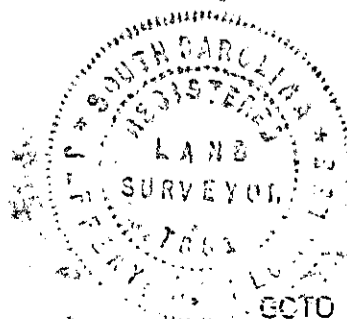

Jeffery M. Plumblee
R.L.S. No. 7881

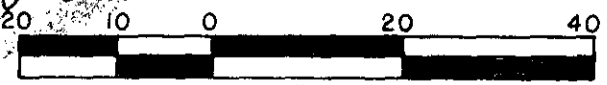

Scale 001' = 20' 5.0000