


AMHERST AVE

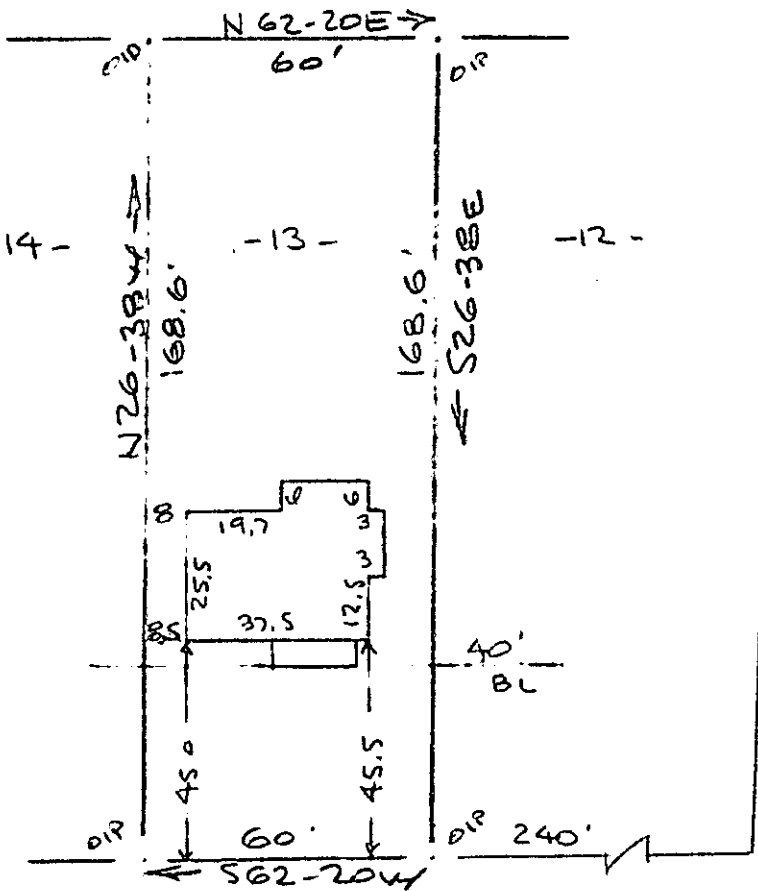

Note: Improvements on this lot are not in a flood hazard area.

TYLER ST

31838

9-T-31

PROPERTY OF
DEBRA MARIE COURVILLE
 GREENVILLE, S.C.
 40 23 MAY 0 1983 40'

MAY 27 1983

This is to certify that on the 23rd day of May, 1983, I surveyed the property shown on this plat, being known as lot 13 on plat of MAP OF AUGUSTA HEIGHTS and recorded in the RMC Office Greenville County, S. C., in Plat Book " K " at Page 88; and that the property lines, walls and buildings are as shown hereon, and that the walls and buildings located on said lot do not encroach or project on adjacent street or property, and that no adjacent walls or buildings encroach or project on said premises, and no power lines cross this property except as shown hereon.

R. B. Bruce
 R. B. Bruce, RLS #1952

CAROLINA SURVEYING CO.
 112 Manly St.
 Greenville, S. C.

FILED
 GREENVILLE CO S.C.
 MAY 27 1 37 PM '83
 DONNIE S. TAMMERSLEY
 R.M.C.

SCTD -----2 MAY 27 83 500 3.00CI