MICROFILMED

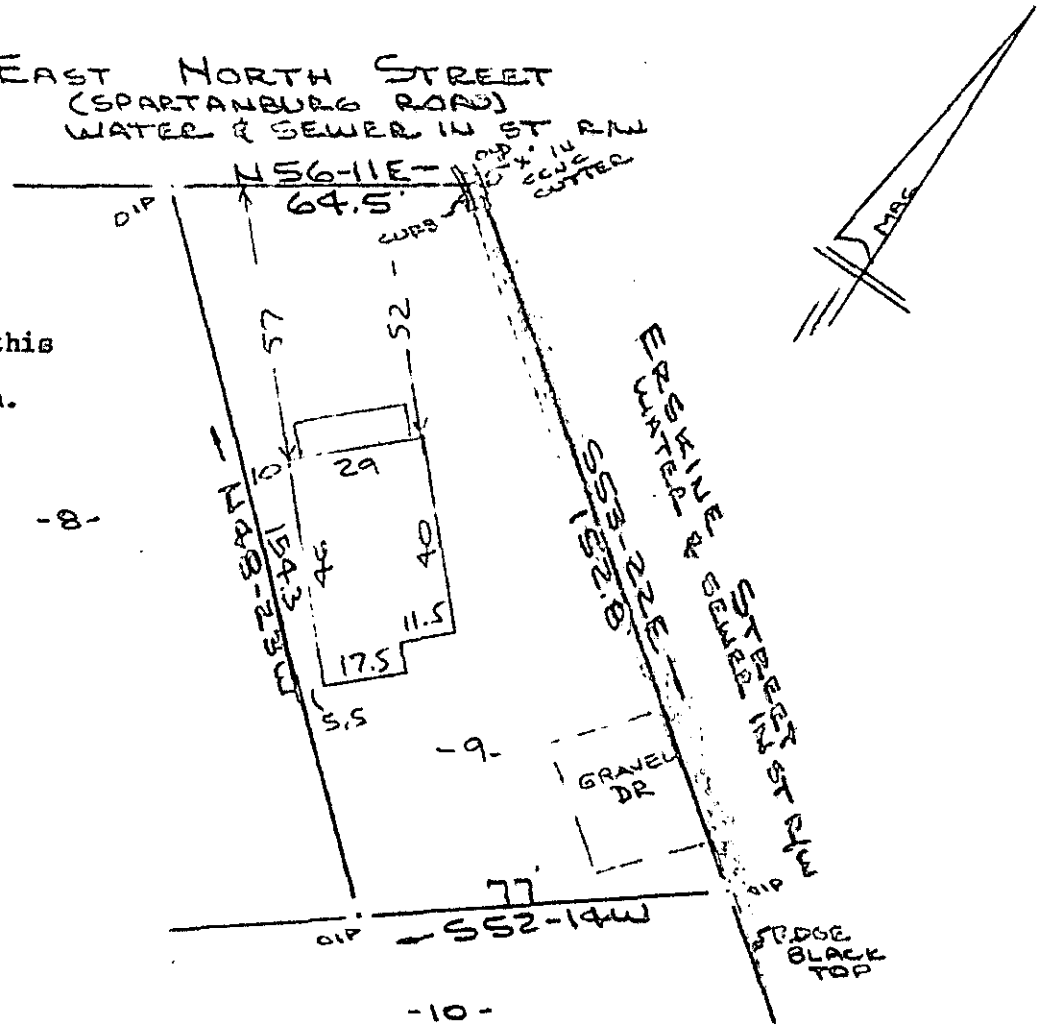

Note:
Improvements on this lot are not in a flood hazard area.

FILED
GREENVILLE CO. S.C.
MAY 27 3 10 PM '83
DONNIE S. TANKERSLEY
R.M.C

PROPERTY OF
HOANG MINH THU & TRAN HOANG HOA
GREENVILLE COUNTY, GREENVILLE, S.C.
26 MAY 1983

40 20 0 40

This is to certify that on the 26th day of May, 1983, I surveyed the property shown on this plat, being known as lot 9 on plat of PROPERTY OF HOANG MINH THU & TRAN HOANG HOA and recorded in the RMC Office Greenville County, S. C., in Plat Book 9-T at Page 34 ; and that the property lines, walls and buildings are as shown hereon, and that the walls and buildings located on said lot do not encroach or project on adjacent street or property, and that no adjacent walls or buildings encroach or project on said premises, and no power lines cross this property except as shown hereon.

9-T-34

31841

R. B. Bruce

R. B. Bruce, RLS #1952

CAROLINA SURVEYING CO.
112 MANLY ST.
GREENVILLE, S.C.

SCTO ----- 3 MY27 83 012 3.00CD