


MICROFILMED

S.C. HWY. NO 14
WATER IN ST. R/W
S4-S1E →

MAG 1962

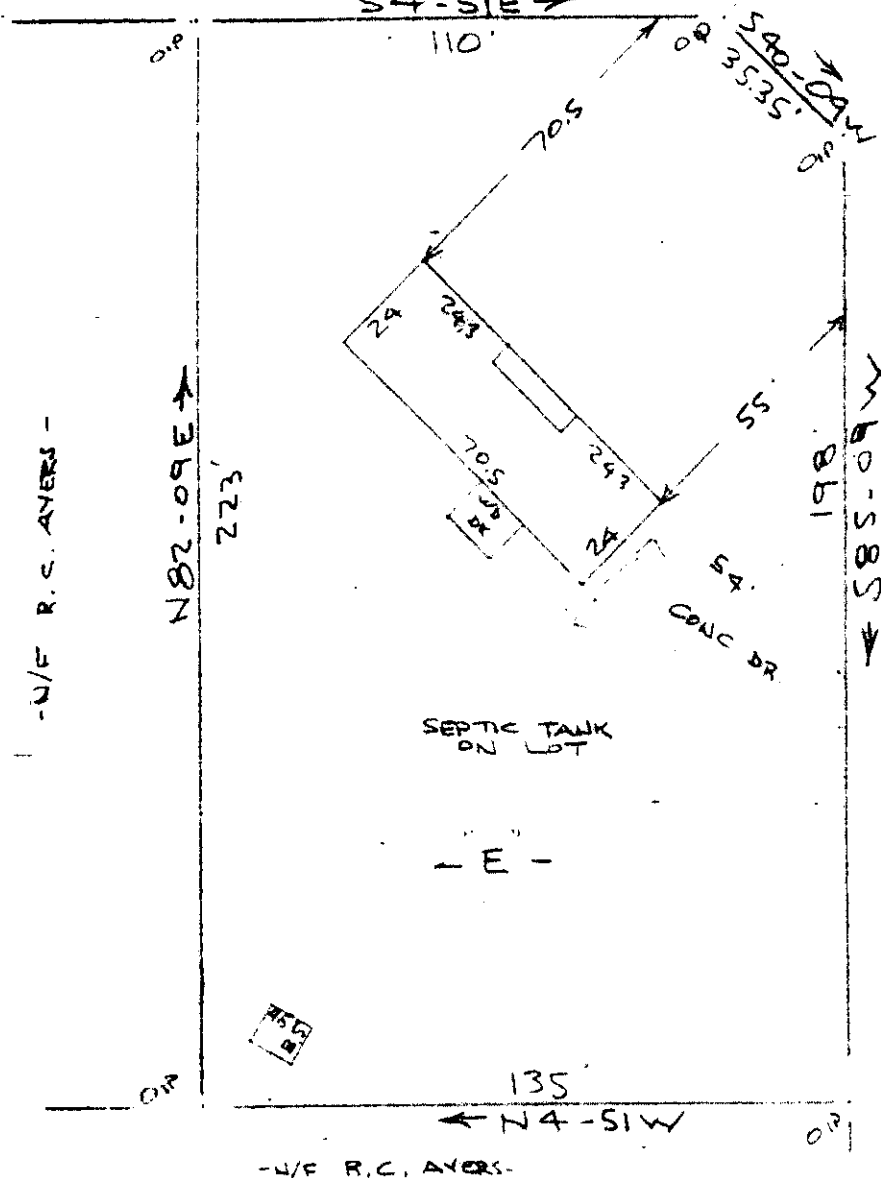

FILED
GREENVILLE CO. S.C.
JUN 1 2 44 PM '83
DONNIE S. JANKERSLEY
R.M.C.

Note: Improvements on this lot are not in a flood hazard area.

JUN 1 1983
9-T-67

PROPERTY OF
DAVID L. DORRITY & LEANNE A. DORRITY
NEAR GREENVILLE, S.C.
40 30 MAY 0 1983 40

32481

This is to certify that on the 30th day of May, 1983, I surveyed the property shown on this plat, being known as lot "E" on plat of property of R. C. Ayers and recorded in the RMC Office Greenville County, S. C., in Plat Book "6 - W" at Page 79; and that the property lines, walls and buildings located on said lot do not encroach or project on adjacent street or property, and that no adjacent walls or buildings encroach or project on said premises, and no power lines cross this property except as shown hereon.

R. B. Bruce, RES 1952

CAROLINA SURVEYING CO.
112 Manly St.
Greenville, S. C.

MICROFILMED

5070 -----2 MY31 83 1134

3.00CI

11/752

539-1-985