


MICROFILMED

FILED
GREENVILLE CO. S.C.
JUN 1 3:56 PM '83
DONNIE S. JENNENSLEY
R.M.C.

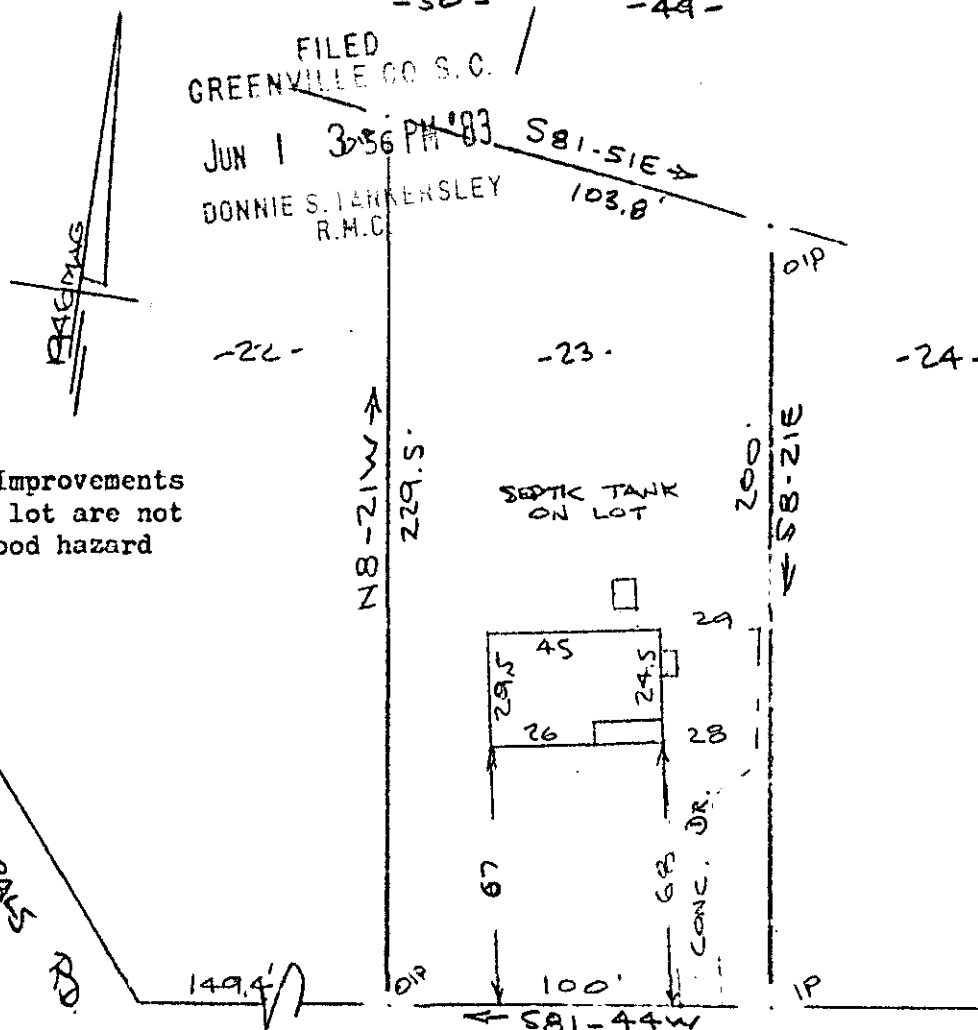

Note: Improvements on this lot are not in a flood hazard area.

FORK SHOALS RD

HENDERSON AVE
WATER IN ST. R/W

JUN 1 1983

PROPERTY OF
JESSIE J. THOMAS & SUSAN T. THOMAS
NEAR GREENVILLE, S.C.
50 MAY 0 1983 50'

32467

9-T-75 ✓

This is to certify that on the 31st day of May, 1983, I surveyed the property shown on this plat, being known as lot 23 on plat of AUGUSTA ACRES and recorded in the RMC Office Greenville County, S. C., in Plat Book " S " at Page 201 and also being known as PROPERTY OF JESSIE J. THOMAS & SUSAN T. THOMAS and recorded in Plat Book at Page ; and that the property lines, walls and buildings are as shown hereon, and that the walls and buildings located on said lot do not encroach or project on adjacent street or property, and that no adjacent walls or buildings encroach or project on said premises, and no power lines cross this property except as shown hereon.

CAROLINA SURVEYING CO.
112 Manly St.
Greenville, S. C.

R. B. [Signature]
REGISTERED
S. C. SURVEYOR
1952

3070 --- 2 MY31 83 1198 3.00CI