

FILED  
GREENVILLE CO. S.C.  
JUN 6 3 52 PM '83  
DONNIE S. TARKERSLEY  
R.M.C.


MILL ESTATES ROAD

EAST MILL COURT

This is to certify that on May 30, 1983, I surveyed the property shown on this plat, known as Lot 26 on the plat of Old Mill Estates, Sec. 3, recorded in the RMC Office of Greenville County in Plat Book 8P on page 3, and that the property lines, walls and buildings are as shown hereon; that the building located on said lot does not encroach or project on adjacent streets or property and that no adjacent walls or buildings encroach or project on said premises, and that no utility lines cross this property except as shown hereon. This property is not located in a designated flood hazard area.

5' drainage & utility easements each side all side & rear lot lines.

JUN 6 1983 *James R. Freeland*  
James R. Freeland PE and RL 4781

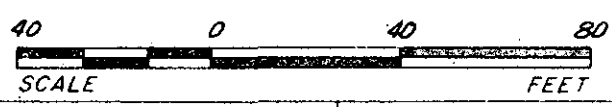

32927 ✓ 9-T-95



STATE OF SOUTH CAROLINA  
GREENVILLE COUNTY  
OLD MILL ESTATES  
SEC. 3 ; LOT 26  
PROPERTY OF  
FURMAN COOPER  
BUILDERS INC.

FREELAND & ASSOCIATES Engineers • Land Surveyors	
GREENVILLE, S.C.	
SURVEY	J.C.
DRAWN	K.E.G.
CHECK	FEL
SCALE	1" = 40'
DATE	5-30-83
DWG. NO.	9057

THE P.F. ASSOCIATES, INC. N30031