


MICROFILMED

FILED
GREENVILLE CO. S. C.

JUN 8 11 38 AM '83

DONNIE S. WILKINSON
R.M.C.

NOTE: Improvements on this lot are not in a flood hazard area.

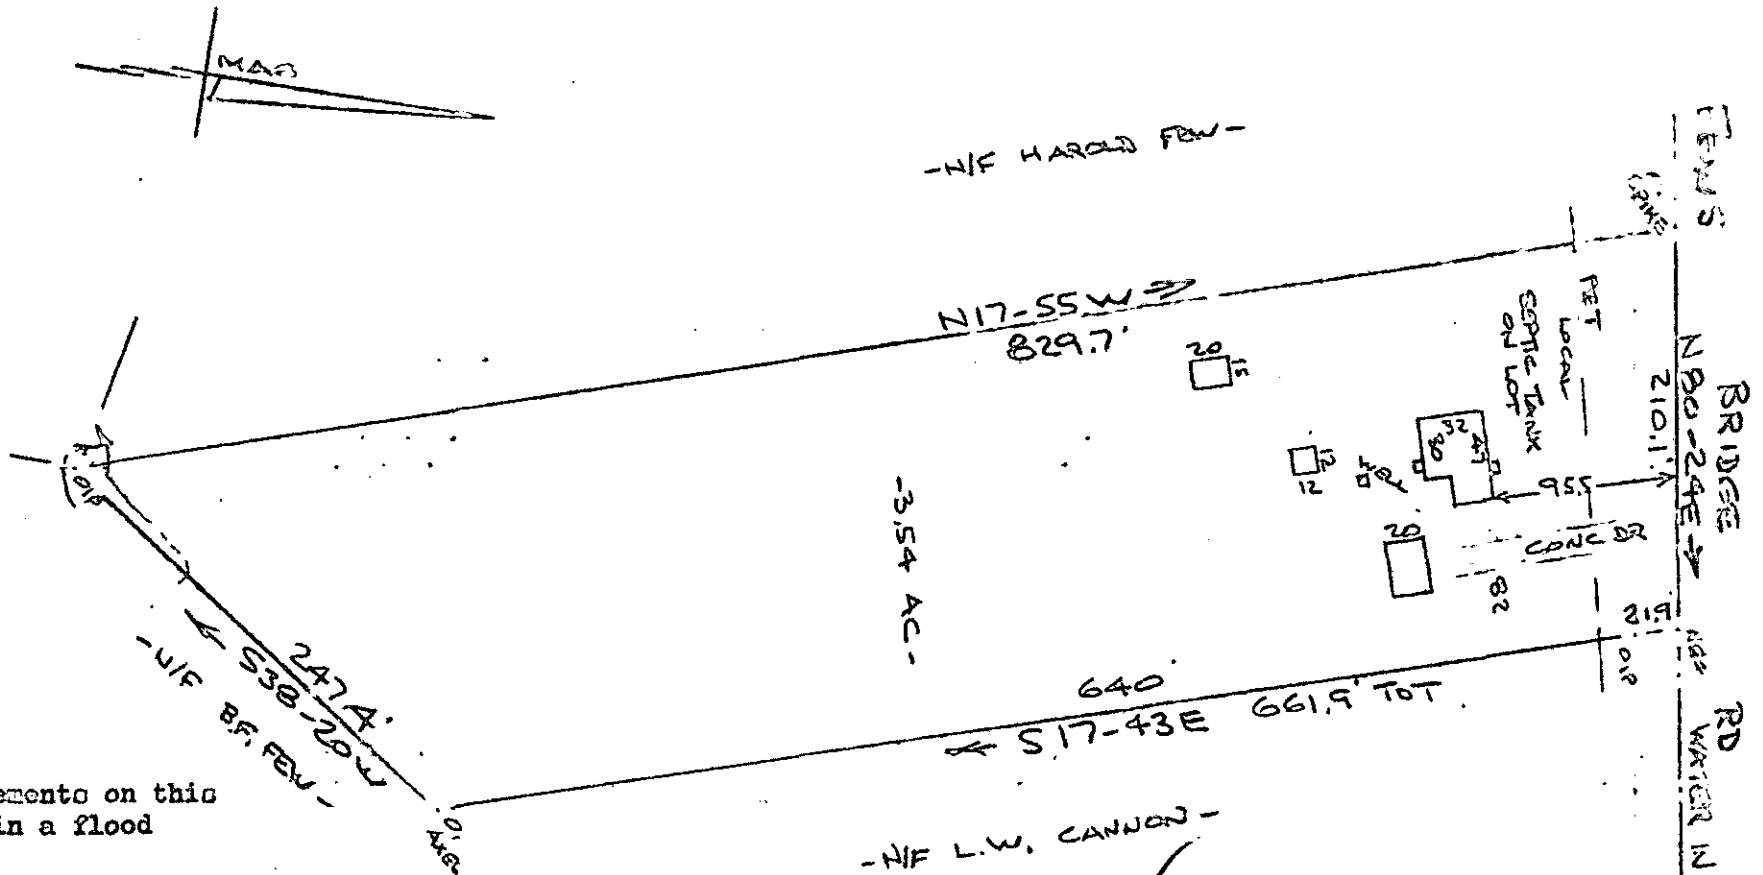

PROPERTY OF
FRANK W. PEARSON
NEAR GREENVILLE, S. C.
100' JUNE 8 1903 100'

✓ JUN 8 1903 33241
9-4-3

This is to certify that on the 1st day of June, 1903, I surveyed the property shown on this plat, being known as lot 3.67 ac on PROPERTY OF FRANK W. PEARSON and recorded in the REC OFFICE Greenville County, S. C., in Plat Book " " at Page ; and that the property lines, walls, and buildings shown hereon, and that the walls and buildings located on said lot do not encroach on any adjacent street or property, and that no adjacent walls or buildings encroach or project on said lot, and no power lines cross this property except as shown hereon.

CAROLINA SURVEYING CO.
412 Mainly St.
Greenville, S. C.

3.00 30042161A01