

This is to certify that on June 7, 1983, I surveyed the property shown on this plat, known as Lot 78 on the plat of Pinebrook Forest, recorded in the RMC Office of Greenville County in Plat Book 4X on pages 48-49 and that the property lines, walls and buildings are as shown hereon; that the building located on said lot does not encroach or project on adjacent streets or property, and that no adjacent walls or buildings encroach or project on said premises, and that no utility lines cross this property except as shown hereon. This property is not located in a designated flood hazard area.


*James R. Freeland*  
James R. Freeland RLS & PE 4781

JUN 8 1983

✓ 9-21-7 33273

NOTE:

There is a 5' drainage & utilities easement along each side & rear lot line

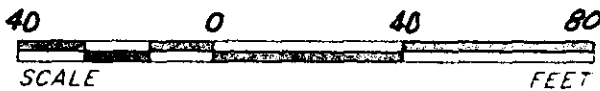

STATE OF SOUTH CAROLINA  
GREENVILLE COUNTY

PINE BROOK FOREST  
SEC. 1 ; LOT 78  
PROPERTY OF  
ELROY H. WEEKE  
JOAN H. WEEKE

FREELAND & ASSOCIATES  
Engineers & Land Surveyors

GREENVILLE SC

SURVEY 06  
DRAWN KEG  
CHECK MC  
SCALE 1" = 40'  
DATE 6-7-83  
Dwg. NO. 9084