MICROFILMED

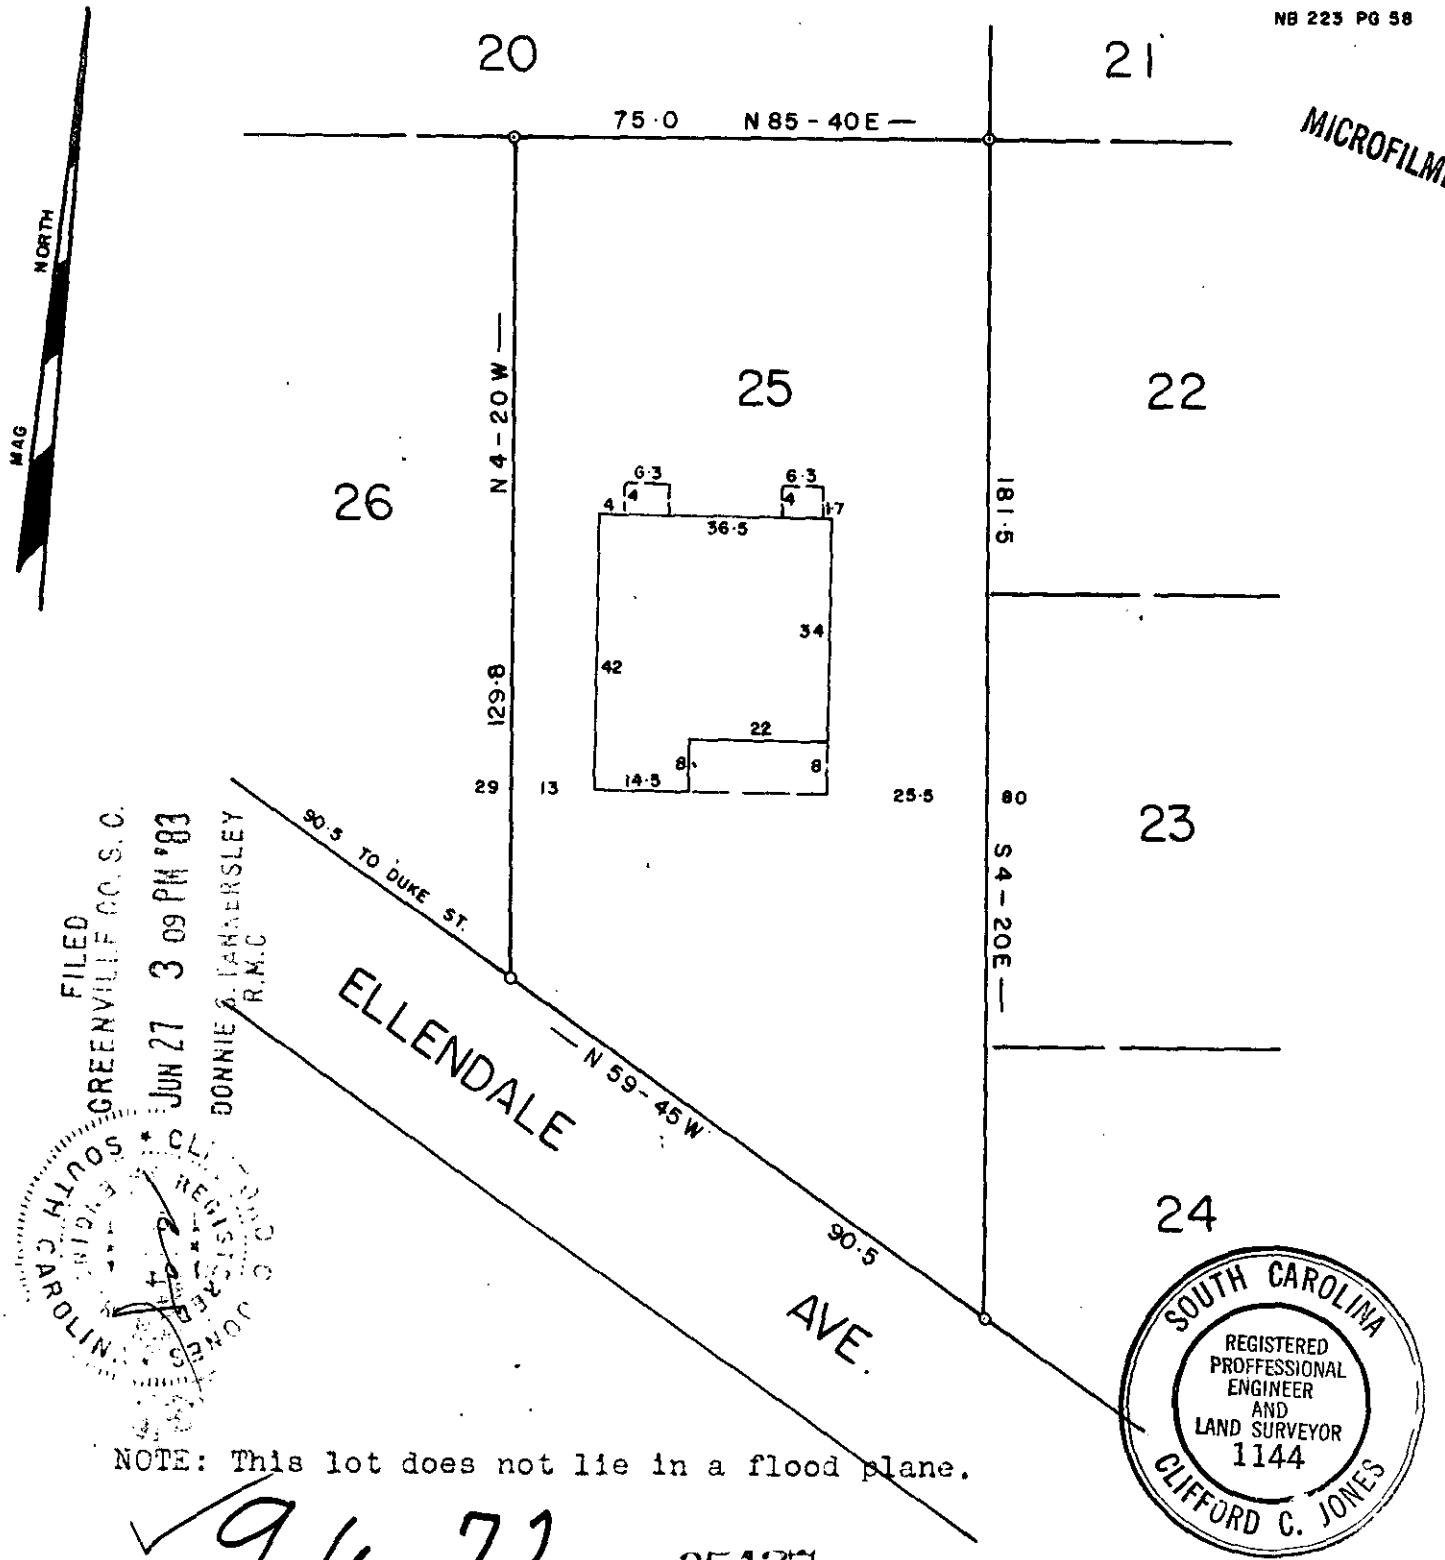

NOTE: This lot does not lie in a flood plane.

9-6-72

35427

This is to certify that on the 21 day of JUNE 1983, I surveyed the property shown on this plat, being LOT 25 NEWLANDS, recorded in Plat Book C 199 of the R.M.C. Office for Greenville County, S. C., and that the property lines, walls and buildings are as shown hereon; that the buildings located on said lot do not encroach or project on adjacent streets or property; and that no adjacent buildings or walls encroach or project on said premises, and that no utility lines cross this property.

Reg. Engineer No. 1144 S.C.

PROPERTY OF DAN S. DAVIS & LAWRENCE M. LENTZ

GREENVILLE COUNTY, S. C.

JUNE - 21 - 1983

SCALE 1" = 30'

0 10 20 30 50 100

JONES ENGINEERING SERVICE 1006 E. PERRY RD.