


MICROFILMED

FILED
GREENVILLE CO. S. C.

JUL 11 3 13 PM '83

DONNIE S. TINKLENSLEY
R.M.C.

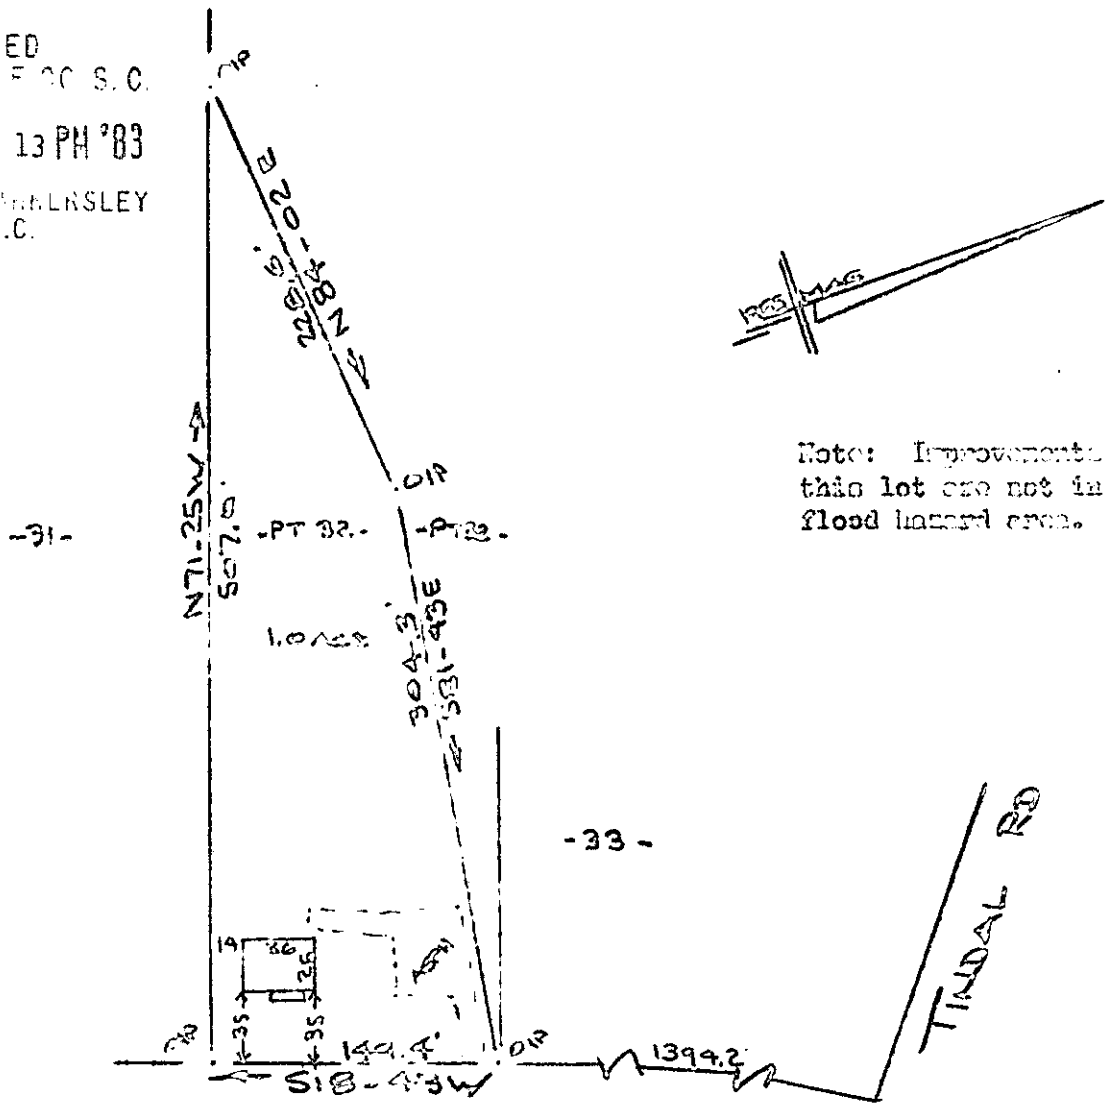

Note: Improvements on this lot are not in a flood hazard area.

WOODLAND DRIVE
WATER & SEWER IN ST. ROW

PROPERTY OF
AMIR KHEZREJAT
NEAR GREENVILLE, S. C.
108' 8" JULY 11 1983

JUL 11 1983

DATE ----- 2 JUL 11 83 450 3.00CI

I hereby certify that on the 8th day of July, 1983, I surveyed the property shown on this plat, being known as part of lot 2 of the KHEZREJAT TRACT as shown on the REC. Office Greenville County, S. C., in Plat Book "J" 108' 8" 7" and also being known as PROPERTY OF AMIR KHEZREJAT and shown on Plat Book _____ at Page _____; and that the property lines, walls and buildings are as shown hereon, and that the walls and buildings are not on any lot do not encroach or project on adjacent street or property, and that no other walls or buildings encroach or project on said property, and no other improvements are on this property except as shown hereon.

✓ 9-V-19

1057



CAROLINA SURVEYING CO.
112 Mary St., Greenville, S. C.