



This is to certify that on June 29, 1983, I surveyed the property shown on this plat, known as Pt. of Lot 779 and Pt. of Lot 780, on the plat of Westwood, Sec. VI, recorded in the RMC Office of Greenville County in Plat Book 6G. on page 16 and that the property lines, walls and buildings are as shown hereon; that the building located on said lot does not encroach or project on adjacent streets or property and that no adjacent walls or buildings encroach or project on said premises, and that no utility lines cross this property except as shown hereon. This property is not located in a designated flood hazard area.

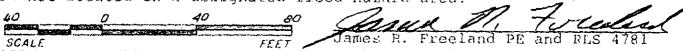

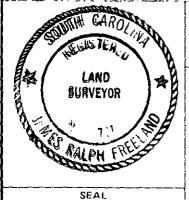

STATE OF SOUTH CAROLINA GREENVILLE COUNTY 14

JUL 111983 ESTWOOD 9- V. 24

SEC. 17, PT. LOT 779 & PT. LOT 780

PROPERTY OF CLIFFORD A. DE MERRITT

SUSAN TO DE MERRITT

FREELAND & ASSOCIATES

Fingineers • Land Surveyors

GREENVILLE, S.C.

	
SURVEY D.G,	
DRAWN 8.A.	
CHECK MC	
SCALE /" = 40'	3.0000
WATE JUNE 29.8	3
DWG. NO. 9252	

PRINT MACHINE, IPC